

County Ellis		Elev. 1975	
Sec. 14	Twp. 15	Rge. 18W	
Company Frontier Oil			
FarmName 1506		No. 5	

TOPS	DEPTH	LOG	DATUM	Loc. in Sec.
Anh.	1142			SW NW SE
Tp.				
H.				
Tr.				
Dg.				
Bl.				
L.				Geol.
K.C.				Contr.
B.K.C.				K & K
Ce.				
C.				Pool
M.				Leiker
M.				
K.				
Mz.				
Me.				
V.				
S.				
S.				
A.				
R.				
Pe.				
G.				
TD.				

Date Comm. 11-10-55	NOV 14 1955
8" @ 1152 drlg. 2068	NOV 15 1955

County Ellis		Elev. 1975	
Sec. 14	Twp. 15	Rge. 18W	
Company Frontier Oil			
FarmName Witt		No. 5	

TOPS	DEPTH	LOG	DATUM	Loc. in Sec.
Anh.	1142			SW NW SE
Tp.				
H.	3217		1242	
Tr.				
Dg.				
Bl.				
L.	3264		1289	Geol.
K.C.				Contr.
B.K.C.				K & K
Ce.				
C.				Pool
M.				Leiker
M.				
K.				
Mz.				
Me.				
V.				
S.				
S.				
A.	3540		1565	
R.				
Pe.				
G.				
TD.	3547			

Date Comm. 11-10-55	DEC 28 1955
8" @ 1152 DST 3541-47 open 1 hr.	
rec. 711' oil 1100/20" 5 1/2" @ 3542	
CO to 3547 S/ 11 boph 4 hr.	
Comp. 110 bopd	

Ellis

KANSAS

SEC.	TWP.	R.
14	15	18W

WELL NO. #5 Witt FARM

COMPANY Frontier Oil

CONTRACTOR K & K


Leiker

_____ Ft. from N. Line

_____ Ft. from S. Line

_____ Ft. from E. Line

_____ Ft. from W. Line

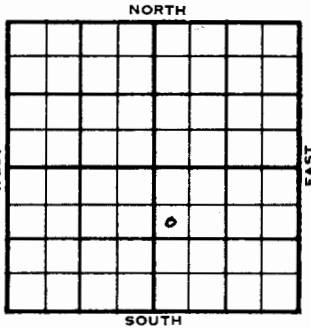

SW NW SE

1955	ELEVATION 1975	REPORT
11/16	CDrm 11/10/55 8" @ 1152 Anh 1142 Drlg 2068	
12-28	DST 3541-47 op 1 hr. rec. 711' oil, 1100/20" 5 1/2" @ 3542 CO to 3547 S/ 11 boph 4 hrs. Comp. 110 bopd H. 3217 L. 3264 A. 3540 TD 3547'	

COMPLETED

DX-78

Ellis

KANSAS

SECTION 14 TOWNSHIP 15 RANGE 18 W

WELL NO. #5 Witt

COMPANY Frontier Oil

