

SEC. 14 TWP. 15 R. 18W ✓

DX 78-1

WELL NO. 1 Witt

Section 14 Township 15 Range 18W

COMPANY FARM

Well No. 1 Witt

CONTRACTOR Frontier Oil

Company Frontier Oil


Rudor Pool

Ft. from N. Line


330 Ft. from S. Line

Ft. from E. Line

330 Ft. from W. Line

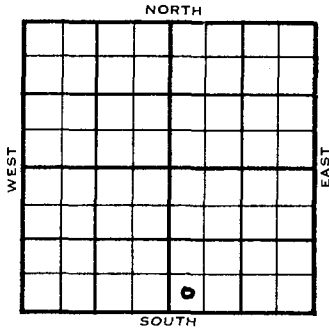

NORTH

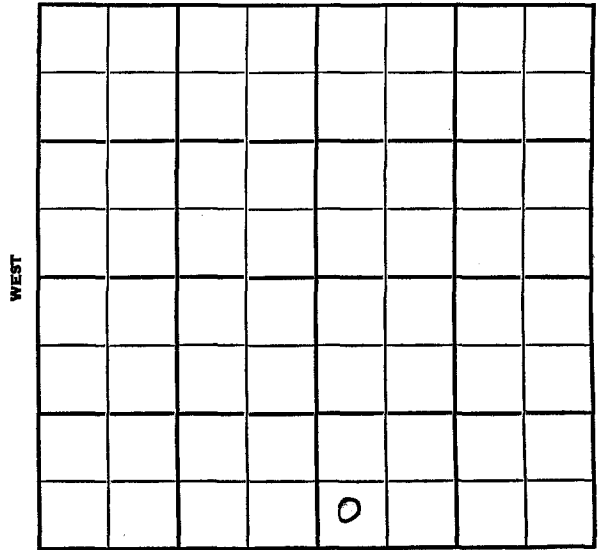

SOUTH

SW SW SE
CSO - DHM

	ELEVATION	REPORT
1954	1979	

7/7 8" @ 1148
Drlg. 2950

8-11 Spdg 6-29-54
Oil well
TD 3551
8" @ 1148
Lans. 3263 Heeb 3217
DST 3310-33 open 1 hr. Rec. 5' mud
O# Arb. 3545
DST 3547-51 open 1 hr. Rec. 320' gas
610' oil 955#
TD 3551
5" @ 3547 CO to 3551 7½ boph
Comp 160 bopd

COMPLETED