

County Ellis Elev. \_\_\_\_\_  
 Sec. 14 Twp. 15 Rge. 18W  
 Company Frontier Oil  
 FarmName Witt No. 3

TOPS	DEPTH	LOG	DATUM	Loc. in Sec.
Anh.				NW SW SE
Tp.				
H.				
Tr.				
Dg.				
Bl.				
L.				Geol.
K.C.				Contr.
B.K.C.				
Ce.				<u>K &amp; K</u>
C.				
M.				Pool
M.				<u>Leiker</u>
K.				
Mz.				
Mo.				
V.				
S.				
S.				
A.				
R.				
Pe.				
G.				
T.D.				

AUG 21 1955  
FIRST REPORT

Date Comm. RUR

County Ellis Elev. 1979  
 Sec. 14 Twp. 15 Rge. 18W  
 Company Frontier Oil  
 FarmName Witt No. 3

TOPS	DEPTH	LOG	DATUM	Loc. in Sec.
Anh.				NW SW SE
Tp.				
H.		<u>3216</u>	<u>1237</u>	
Tr.				
Dg.				
Bl.				
L.		<u>3263</u>	<u>1284</u>	Geol.
K.C.				Contr.
B.K.C.				
Ce.				<u>K &amp; K</u>
C.				
M.				Pool
M.				<u>Leiker</u>
K.				
Mz.				
Mo.				
V.				
S.				
S.		<u>3544</u>	<u>1565</u>	
A.				
R.				
Pe.				
G.				
T.D.		<u>3556</u>		

COMPLETE

Date Comm. 9-28-55 OCT 12 1955  
8 5/8" @ 115/450 DST 3545-51 open 1/2 hr.  
Rec. 8' osm 0/20" DST 3550-56  
open 2 hr. Rec. 360' GIP 1620' clean  
oil 1050/20" 5 1/2" @ 3550/125 CO to  
3556 S/ 17 boph 1/2 hr. Comp. 110 bopd

Ellis

KANSAS

SEC. 14	TWP. 15	R. 18W
---------	---------	--------

WELL NO. #3 Witt FARM

COMPANY Frontier Oil

CONTRACTOR K & K

in ?


\_\_\_\_\_ Ft. from N. Line

\_\_\_\_\_ Ft. from S. Line

\_\_\_\_\_ Ft. from E. Line

\_\_\_\_\_ Ft. from W. Line

NW SW SE

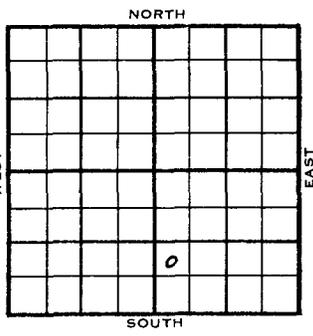

1955	ELEVATION 1979	REPORT
------	----------------	--------

8/31 R U R

10/12 Comm 9-28-55

8 5/8" @ 115/450

H 3216

L 3263

A 3544

TD 3556

DST 3545-51 open 1/2 hr Rec 8' osm

2 0/20" DST 3550-56 open 2 hr

Rec 360' GIP 1620' clean oil

1050/20" 5 1/2" @ 3550/125 CO to

3556 S/17 boph 4 hr Comp 110 bopd

**COMPLETED**

DX-78

DX 78-1

Ellis

KANSAS

Section 14 Township 15 Range 18 W

Well No. #3 Witt

Company Frontier Oil

