

County	Ellis		Elev.	
Sec.	14	Twp.	15	Rge.
Company	Frontier Oil Co.			
Farm Name	Witt		No.	4

TOPS	DEPTH	LOG	DATUM	Loc. in Sec.
Anh.				NE SW SE
TP.				
H.				
Tr.				
Dg.				
Bl.				
L.				
K.C.				Geol.
B.K.C.				Contr. Keifer & Krause
Ce.				Pool
C.				Leiker
M.				
M.				
K.				
Mz.				
Mo.				
V.				
S.				
S.				
A.				FIRST REPORT
R.				
PE.				
G.				
TD.				

Date Comm. SEP 28 1955

MIR

County	Ellis		Elev.	1983
Sec.	14	Twp.	15	Rge.
Company	Frontier Oil			
Farm Name	Witt		No.	4

TOPS	DEPTH	LOG	DATUM	Loc. in Sec.
Anh.	1148			NE SW SE
TP.				
H.	3221		1238	
Tr.				
Dg.				
Bl.				
L.	3269		1286	
K.C.				Geol.
B.K.C.				Contr. Keifer & Krause
Ce.				Pool
C.				Leiker
M.				
M.				
K.				
Mz.				
Mo.				
V.				
S.				
S.				
A.	3561		1528	COMPLETE
R.				
PE.				
G.				
TD.	3568			

Date Comm. 10-1-55 NOV 23 1955

8 5/8" @ 1158 DST 3562-68 open 1 1/2 hr.
 rec. 120' GTP 190' gassy oil 1100/20"
 5 1/2" @ 3563 CO to 3568 B/1 boph 1/2 hr.
 250 A S/5 boph 6 hr. P/6 boph
 Comp. 96 bopd 2% wtr.

Ellis

KANSAS

SEC.	TWP.	R.
14	15S	18W


WELL NO. #14 Witt

COMPANY Frontier Oil Co. FARM

CONTRACTOR Keifer & Krause

Leiker

_____ Ft. from N. Line
 _____ Ft. from S. Line
 _____ Ft. from E. Line
 _____ Ft. from W. Line

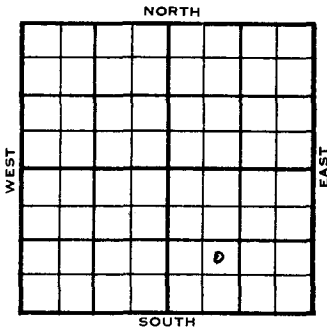

NE SW SE

1955	ELEVATION 1983'	REPORT
------	--------------------	--------

9/28 MIRT
 11-23 Comm. 10-1-55
 8 5/8" @ 1158
 DST 3562-68 op 1 1/2 hr. rec. 120' GIP,
 190' gassy oil, 1100/20"
 5 1/2" @ 3563
 CO. to 3568
 B/ 1 boph 4 hrs., 250 A,
 S/ 5 boph 6 hrs.
 P/ 6 boph
 Comp. 96 bopd, 2% wtr.
 Anh. 1148
 H. 3221'
 L. 3269
 A. 3561
 TD. 3568'

COMPLETED

DX-78

DX 78-1

Ellis

KANSAS

Section 14 Township 15 S Range 18 W

Well No. #14 Witt

Company Frontier Oil Co.

