

Ellis KANSAS

SEC. 15 TWP. 15 R. 18W

WELL NO. 3 Wasinger FARM

COMPANY Phillips Petr.

CONTRACTOR Phillips


Leiker Pool 990 Ft. from N. Line

Ft. from S. Line

660 Ft. from E. Line

Ft. from W. Line

C S L N E N E

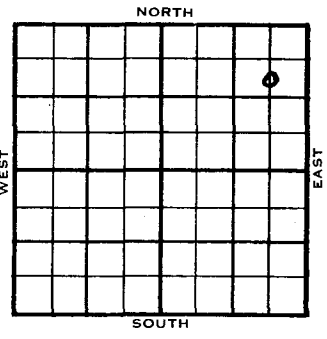


Ellis KANSAS

FORM 51 Section 15 Township 15 Range 18W

Well No. #3 Wasinger

Company Phillips Pet.

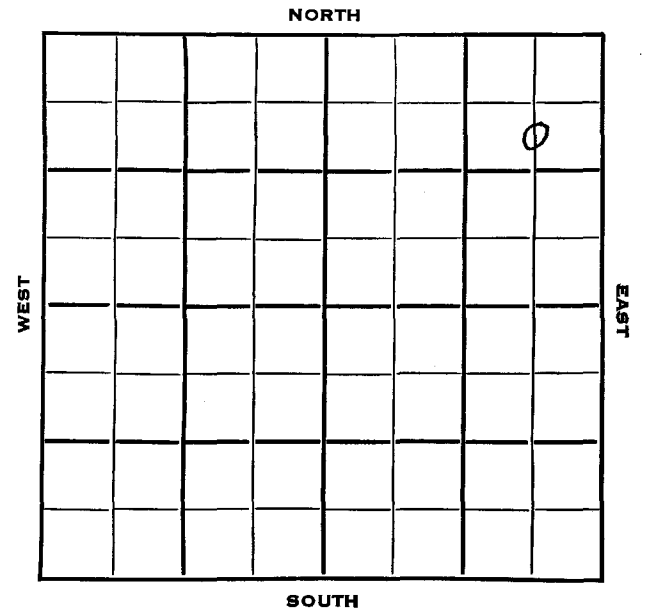

1953 ELEVATION REPORT 2003'

11/11 RUR
 11/18 Anhy 1164'
 10" @ 1175'
 Drlg. 2179'
 12/16 Spud 11-12-53 Oil well TD 3615
 Anhy 1164 Howard 2975 10" @ 1175
 Top. 3015 Heeb 3242 Tor. 3262
 Lans. 3291 B KC 3526' Marm 3536
 Schl tops: Howard 2971' Top. 3010'
 Heeb 3240' Tor. 3260' Lans. 3291'
 B KC 3526 Marm 3535 Cong 3566'
 Arb. 3601' TD 3604 7" @ 3602
 DD 3614 S/3/4 BO 3.34 BWPH 500 A
 S/109 BO 1 BW 6 hr. CO to 3615
 Comp. 193 BOPD 193 BW

COMPLETED