

Ellis

KANSAS
Map No. 77 Sec. 15 Twp. 15 R. 18WWell No. 2 Wasinger

Phillips

Company

FIRST REPORT

Contractor

C N L NW NE

SECTION PLAT

330 Ft. from N. Line

Ft. from S. Line

Ft. from E. Line

660 Ft. from W. Line

Liekar Pool

Location X

Rig up

Drilling and Remarks:

RECORD

Cased in, ft.

Sand

Gas

Oil

Total Depth

PRODUCTION

1st 24 hrs. Nat.

1st 24 hrs. after shot

Gas Cu. Ft.

Dry Hole

Abandoned

Date

FEB 16 1944 19

S. J. LEWIS

Scout

Ellis

KANSAS
Map No. 74 Sec. 15 Twp. 15 R. 18WWell No. 2 Wasinger

Phillips

Company

ABANDONED

Contractor

C N L NW NE

SECTION PLAT

330 Ft. from N. Line

Ft. from S. Line

Ft. from E. Line

660 Ft. from W. Line

Liekar Pool

Location

Rig up

Drilling and Remarks:

Oil 3615

RECORD

Cased in, ft.

Sand

Gas

Oil

Total Depth 3646

PRODUCTION

1st 24 hrs. Nat.

1st 24 hrs. after shot

Gas Cu. Ft.

Dry Hole

Abandoned

Date

MAR 15 1944 19

S. J. LEWIS

Scout

Ellis

KANSAS

Ellis

Sec. 15 Twp. 15 R. 18W

Well No. #2 Wasinger Farm

Phillips Company


Liekar

330 Ft. from N. Line

 Ft. from S. Line

 Ft. from E. Line

660 Ft. from W. Line

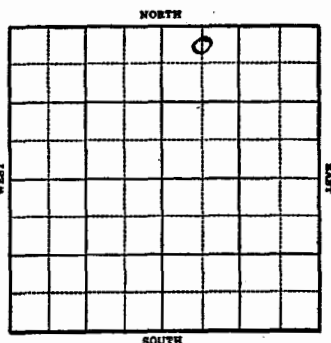


Section 15 Township 15 Range 18W

Well No. #2 Wasinger

Company Phillips

NORTH

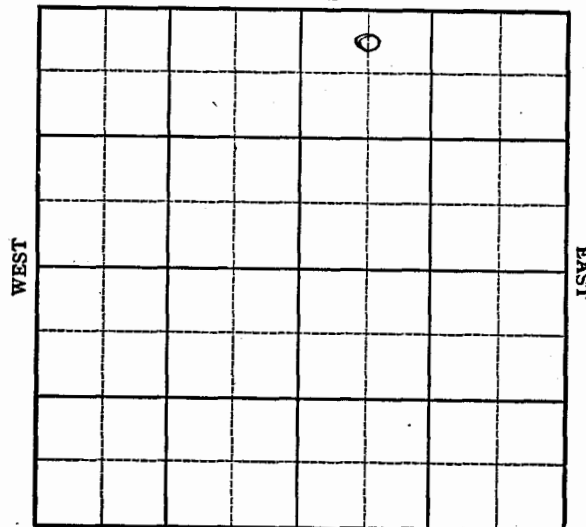

SOUTH

REPORT

1944

2/16 Location
2/23 Rotary
3/1 Anhy 1156
8" @ 1164
Drlg 1827'
3/8 Lans 3295 SSO
3323-27
Drlg. 3456
3/15 Arb. 3615
TD 3646

ABANDONED