


County Ellis State Kansas
 Sec. 15 (Blk. 15 (Sur. 18W Map No.
 Operator Frontier Oil & Strain Drlg.
 Well No. 1 Farm Wassinger
 Elev. _____ Location C N L SE NE

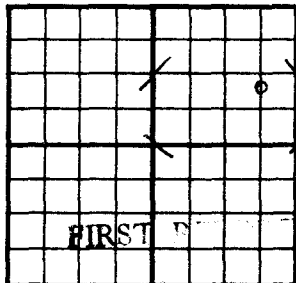


990 Ft. From S Line NE
660 Ft. From E Line Quarter
 Ist. Report SEP 16 1953
 Completion _____
 Remarks _____
Strain Drlg. - Contr.
 Spudding Date _____

Drlg. Data

Location

J. G. McGEHEE

County Ellis State Kansas
 Sec. 15 (Blk. 15 (Sur. 18W Map No.
 Operator Frontier Oil & Strain Drlg.
 Well No. 1 Farm Wassinger
 Elev. 2004 Location C N L SE NE

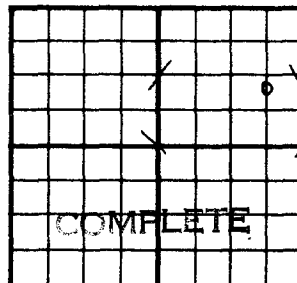

990 Ft. From S Line NE
660 Ft. From E Line Quarter
 Ist. Report _____
 Completion NOV 18 1953
 Remarks _____
Strain Drlg. - Contr.
 Spudding Date 9-18-53

Drlg. Data Oil well TD 35928" @ 185 Anhy 1166 Heeb. 3240Tor. 3262 Lans. 3279 DST 3276-3320open 2 hr. Rec. 120' gcm 120' so & gcm180' vho & gcm 120' mco 420' wco90' sw 780# Arb. 3587 DST 3584-92open 1 hr. Rec. 300' gas 550' oil1000# TD 3592 5" @ 3589 CO to 35923 boph 500 A S/ 12 boph 8 hr.Comp. 200 bopd

J. G. McGEHEE

Ellis KANSAS

SEC. 15	TWP. 15	R. 18W	✓
---------	---------	--------	---


WELL NO. _____

#1 Wassinger

COMPANY _____ FARM _____

CONTRACTOR **Frontier Oil & Strain Drlg.**

Strain Drlg.

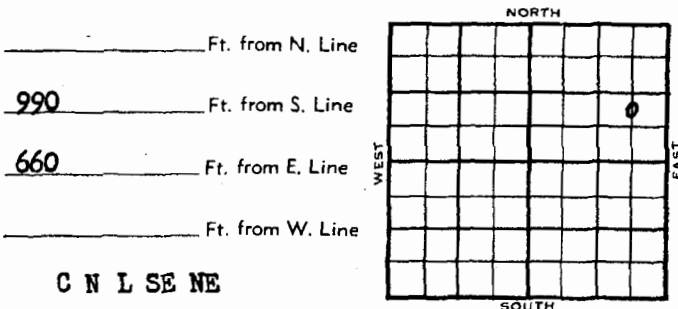

1953
11/18

Spud 9-18-53
Oil Well
TD 3592'
8" @ 185'
Anhy 1166', Heeb 3240', Tor. 3262',
Lans 3279'
DST 3276-3320', opn 2 hrs., rec.
120' gcm, 120' so & gcm, 180' vho &
gcm, 120' mco, 420' wco, 90' sw,
780#
Arb. 3587'
DST 3584-92', opn 1 hr., rec. 300'
gas, 550' oil, 1000#
TD 3592'
5" @ 3589'
CO to 3592' 3 boph 500A
S/12 boph 8 hrs.
Comp. 200 bopd

COMPLETED

	ELEVATION	REPORT
1953	2004'	
9/16	Location	
9/23	8" @ 185 Anhy 1166 Drlg. 1995'	
9/30	Heeb 3240, Tor 3262, Lans 3279 DST 3276-3320' 2 hrs, 120' gcm, 120' so & gcm, 180' V HO&GCM, 120' MCO, 420' WCO, 90' SW, 780# 20". Drlg 3460'	
10/7	Arb. 3587' DST 3584-92, 1 hr, 300' gas, 550' oil 1000# RTD 3592' 5" @ ?	
10/14	5" @ 3589'	
10/21	CO 3592' 3 BOPH 500 A S/12 BOPH 8 hrs.	
10/28	NR	
11/4	"	
11/11	"	

OVER

Section 15 Township 15 Range 18WWell No. 1 WassingerCompany Frontier Oil & StrainD_g.