

County		Ellis	State		Kansas
Sec.	15	(Blk. Twp.)	15	(Sur. Rge.)	18W Map No.
Operator		Frontier Oil			
Well No.		2	Farm		Paul Wassinger
Elev.		2004	Location		SW SE NE
		330 Ft. From S Line NE			
		990 Ft. From E Line Quarter			
		Ist. Report FEB 3 1954			
		Completion			
		Remarks Strain Drlg. - Contr.			
		Spudding Date			
Drlg. Data		Leiker Pool			
Cellar & pits					

County	Ellis	State	Kansas
Sec.	15	(Blk. Twp.)	15 (Sur. Rge.) 18W Map No.
Operator	Frontier Oil		
Well No.	2	Farm	Paul Wassinger
Elev.	2004	Location	SW SE NE
		330 Ft. From S Line NE	
		990 Ft. From E Line Quarter	
		1st. Report	
		Completion APR 28 1954	
		Remarks Leiker Pool	
		Strain Drlg. - Contr.	
		Spudding Date 2-13-54	
Drlg. Data	D & A	TD	3593
8" @ 1165 Anhy 1155 Heeb. 3248			

J. G. McGEHEE

J. G. McGEHEE

Ellis KANSAS
 SEC. 15 TWP. 15 R. 18 W ✓
 WELL NO.

2 Paul Wassinger FARM

COMPANY Frontier Oil

CONTRACTOR Strain Drlg.
 Leiker Pool


Ft. from N. Line

330 Ft. from S. Line

990 Ft. from E. Line

Ft. from W. Line

SW SE NE

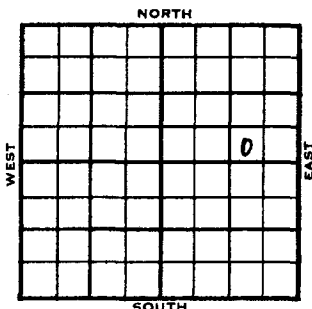

	ELEVATION	REPORT
1954	2004'	
2/3	Cellar & Pits	
2/17	8" @ 1168'	
2/24	Anhy 1155', Heeb 3248', Tor 3269', Lans 3293' DST 3295-3320', 1 hr., 180' gas, 300' HOCM, 300' M & GCO, 340' SW, 850# DST 3342-62', 1 hr., 31' SOCM, 1100# Drlg. 3535'	
3/3	Arb. 3580' RTD 3585' 5" @ 3582' DD 3593' NS Log 500A	
3/10	NR	
3/17	"	
3/24	"	
4/7	"	

OVER

1954
 4/28

Spud 2-13-54

D&A

TD 3593'

8" @ 1165'

Anhy 1155', Heeb 3248', Tor 3269',
 Lans 3293'

DST 3295-3320', opn 1 hr., rec. 180'
 gas, 300' HOCM, 300' mud & GCO,
 240' SW, 850#

DST 3342-62', opnl hr., rec. 31'
 socm, 1100#

Arb. 3580'

TD 3585'

5" @ 3582'

DD 3593', 500A

SP 3350

12/3344-47', 500A

HFW

SP 3325

16/3315-19, 500A wtr.

SP 3302, 12/3295-98, 500A

CO to 3593, 6/3580-82, 1000A

2 go 3 gwph 4 hrs.

Sd-frac

D&A

ABANDONED

FORM 51

Ellis

KANSAS

Section 15 Township 15 Range 18 W

Well No. # 2 Paul Wassinger

Company Frontier Oil

