

County Ellis Elev. _____
 Sec. 15 Twp. 15 Rge. 18W
 Company Frontier Oil
 Farm Name Al Wasinger No. 4

TOPS	DEPTH	LOG	DATUM	Loc. in Sec.
				SW NE SE
Anh.				
Tr.				
H.				
Tr.				
Dg.				
Bl.				
L.				
K.C.				Geol.
B.K.C.				Contr.
Ce.				<u>Sierra</u>
C.				
M.				Pool
M.				<u>Leiker</u>
K.				
Nz.				
Mo.				
V.				
S.				
S.				
A.				
R.				
Pe.				
G.				
T.D.				

Date Comm. 5-27-56
 drlg. 1083

FIRST REPORT
 MAY 29 '56

County Ellis Elev. 2001
 Sec. 15 Twp. 15 Rge. 18W
 Company Frontier Oil
 Farm Name Al Wasinger No. 4

TOPS	DEPTH	LOG	DATUM	Loc. in Sec.
				SW NE SE
Anh.	<u>1155</u>			
Tr.				
H.	<u>3242</u>			
Tr.				
Dg.				
Bl.				
L.	<u>3216</u>			Geol.
K.C.				Contr.
B.K.C.	<u>3275</u>			<u>Sierra</u>
Ce.				
C.				Pool
M.				<u>Leiker</u>
M.				COMPLETE
K.				
Nz.				
Mo.				
V.				
S.				
S.				
A.	<u>3500</u>			JUL 25 1956
R.				
Pe.				
G.				
T.D.	<u>3570</u>			

Date Comm. 5-27-56
 drlg. 1083 JUN 5 '56 8" 1165/650

DST 3322-50 (60) 8" 1165/650
 905' SW BOP 1020 (00)
 DST 3561-70 (60) 20' 600M
 120' from well 120' o.i. BOP 850
 MID 3530 5" 3562/100
 WOC JUN 13 '56 CO 3570 3 4 BOP
 Mr. Leiker POP JUN 20 '56 JUN 27 '56
 JUL 3 '56 JUL 17 '56 JUL 18 '56 JUL 25 '56 Ph P.
 20 Bopd no/w

Ellis

KANSAS

SEC. 15 TWP. 15 R. 18W

WELL NO. #4 Al Wasinger FARM

COMPANY Frontier Oil

CONTRACTOR Sierra

Leiker


FT. FROM N. LINE

FT. FROM S. LINE

FT. FROM E. LINE

FT. FROM W. LINE

SW NE SE

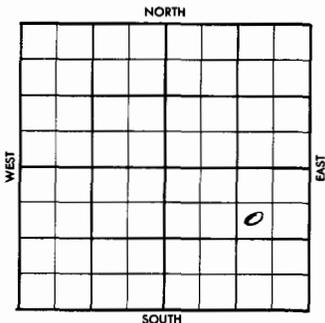

DX 78-1 Ellis


KANSAS

Section 15 Township 15 Range 18W

Well No. #4 Al Wasinger

Company Frontier Oil

NORTH

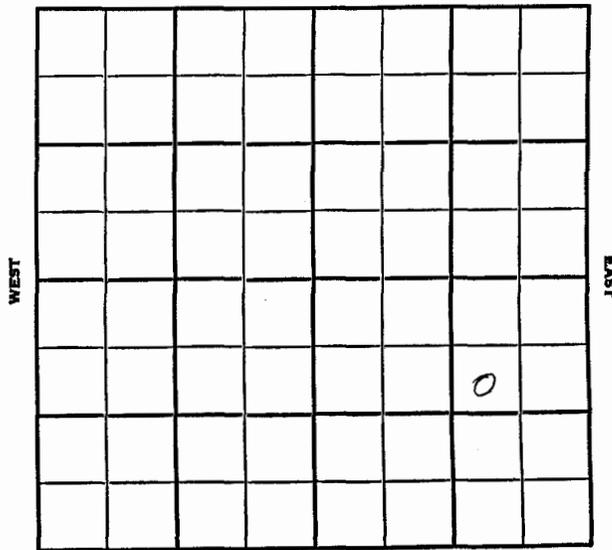

SOUTH

	ELEVATION	REPORT
1956	2001'	

5-29 Comm. 5-27-56
Drlg. 1083'

7-25 8" @ 1165 w/450
 DST 3322-50 op 60 min, rec. 905' SW,
 BHP 1020/20"
 DST 3561-70 op 60 min. rec. 20' G&OCM
 120' froggy oil, 120' oil, BHP 890/
 5 1/2" @ 3562 w/100
 CO 3570
 S/ 4 BOPH, nw/6 hrs.
 P/ 80 BOPD no/wtr.
 Anh. 1155'; H. 3242'; L. 3286';
 BKG ~~355~~ 3515; A. 3560';
 TD 3570'

COMPLETED