


**LOT FILE**      **Ellis**      **KANSAS**

SEC. 15      TWP. 15      R. 18W

WELL NO. **2 Wassinger**      **FARM**

COMPANY **Frontier Oil**

CONTRACTOR **Rocket Leiker**

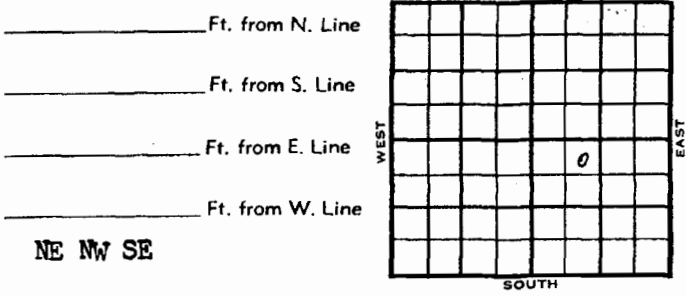

Offset - SDX

1955	ELEVATION 2012'	REPORT
6/22		Location
6/20		Spud 6/21/55, 8/58" @ 1134/500, drlg. 3108.
7/14		Lost surface casing, skidded 40' east 8 5/8" @ 1185' / 450 Anhy 1175, Heeb 3253 mans. 3300, Cong. 3355, Arb 3569, TD 3594, DST 3570-79, open 1 hr. rec 15' mud, 500/20", DST 3579-95, open 1 hr. rec. 40' ho & gcm, 270' oil 900/20" 5 1/2" @ 3579.
7/22		CO to 3594, S/4 boph, S/7 boph, 6 hr. T & R
7/28		No report
8/4		No report
8/10		No report
8/18		No report
8-24		8 5/8" @ 1134/500 lost surface csg. skid 40' east 8 5/8" @ 1185/450 DST 3570-79 open 1 hr., rec. 15' mud 500/20" DST 3579-94 open 1 hr., rec. 40' ho & gcm 270' oil 900/20" 5 1/2" @ 3579 CO to 3594 S/ 4 boph S/ 7 boph 6 hr., Comp. 86 bopd

DX-78

8-24

Anh. 1175, H. 3253, 1201, L. 3300, 1288,  
C. 3555, 1543, A 3569, 1557, T.D. 3594,

COMPLETED



DX 78-1

Ellis

**KANSAS**

Section 15 Township 15 Range 18W

Well No. 2 Wassinger

Company Frontier Oil

