

Ellis KANSAS


SEC.	TWP.	R.
15	15	18W

WELL NO. 1 Peter Dinges FARM

COMPANY Frontier Oil et al

CONTRACTOR Schafer Schoechen Pool

330 Ft. from N. Line
 _____ Ft. from S. Line
 _____ Ft. from E. Line
330 Ft. from W. Line

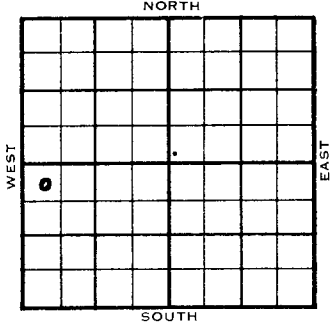

NW NW SW

ELEVATION	REPORT
1955	

4/20 MIR

DX 78-1

Ellis KANSAS

Section 15 Township 15 Range 18W

Well No. 1 Peter Dinges

Company Frontier Oil et al

