

Kansas

Map No. _____ Sec. 15 Twp. 15 R. 18W

Well No. 1 Wassinger

Jones, Shelborne & Farmer Company

Contractor

SE SE SE

SECTION PLAT



Ft. from N. Line

330

Ft. from S. Line

330 Ft. from E. Line

Ft. from W. Line

Ellis County

Sunray & CSO DEH

Location _____

Rig up _____

Drilling and Remarks:

R U R

RECORD

Cased _____ in., _____ ft.

Sand _____

Gas _____

Oil _____

Total Depth _____

PRODUCTION

1st 24 hrs. Nat. _____

1st 24 hrs. after shot _____

Gas _____ Cu. Ft.

Dry Hole _____

Abandoned _____

Date

MAR 22 1950 19

J. E. TYRA

Scout

Kansas

Map No. _____ Sec. 15 Twp. 15 R. 18W


Well No. 1 Wassinger

Jones, Shelborne & Farmer Company

Contractor

SE SE SE

SECTION PLAT

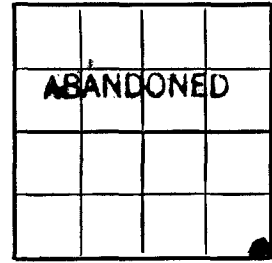

Ft. from N. Line

330

Ft. from S. Line

330

Ft. from E. Line

Ft. from W. Line

Ellis County

Location _____

Rig up _____

Drilling and Remarks:

8" @ 199
 Kurb 3247
 Dodge 3268
 H.C. 3295
 B.K.C. 3540
 Cury 3576

Date

APR 5 1950 19

J. E. TYRA

Scout

RECORD

Cased _____ in., _____ ft.

Sand _____

Gas _____

Oil _____

Total Depth 3660

PRODUCTION

1st 24 hrs. Nat. _____

1st 24 hrs. after shot _____

Gas _____ Cu. Ft.

Dry Hole _____

Abandoned _____

Ellis KANSAS

Sec. 15 Twp. 15 R. 18W

Well No. #1 Wassinger Farm

Jones, Shelborne & Farmer Company

Contractor


Ft. from N. Line

330' Ft. from S. Line

330' Ft. from E. Line

Ft. from W. Line

SE SE SE

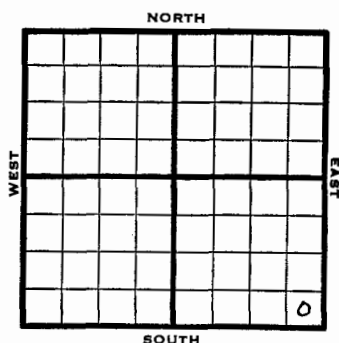

1950 Elev 2005' REPORT

3/22 RUR

4/5 TD 3660'

8" @ 199'

Heeb 3247'

Dodge 3268'

K C 3295'

BKC 3540'

Cong 3576'

Arb 3605'

D&A

Aband.

ABANDONED

Ellis KANSAS

Section 15 Township 15 Range 18W

Well No. #1 Wassinger

Company Jones, Shelborne & Farmer

