

KANSAS
Map No. 74 Sec. 16 Twp. 15 R. 18WWell No. 1 WolfB & R Drilling CompanyFIRST REPORT Contractor**C S L NW NW****SECTION PLAT**990 Ft. from N. Line

Ft. from S. Line

Ft. from E. Line

660 Ft. from W. Line

Semi-WildcatLocation E

Rig up

Drilling and Remarks:

RECORD

Cased in, ft.

Sand

Gas

Oil

Total Depth

PRODUCTION

1st 24 hrs. Nat.

1st 24 hrs. after shot

Gas Cu. Ft.

Dry Hole

Abandoned

Date

SEP 8 1943 19 S. J. LEWIS Scout**KANSAS**
Map No. 74 Sec. 16 Twp. 15 R. 18WWell No. 1 WolfB. & R. Drilling CompanyABANDONED Contractor**C S L NW NW****SECTION PLAT**990 Ft. from N. Line

Ft. from S. Line

Ft. from E. Line

660 Ft. from W. Line

Semi Wildcat

Location

Rig up

Drilling and Remarks:

Per X 95915' 203607Per X 9591Water**RECORD**

Cased in, ft.

Sand

Gas

Oil

Total Depth 9609**PRODUCTION**

1st 24 hrs. Nat.

1st 24 hrs. after shot

Gas Cu. Ft.

Dry Hole

Abandoned

Date

OCT 27 1943 19 S. J. LEWIS Scout

KANSAS

Ellis

Sec. 16 Twp. 15 R. 18-W

Well No. #1 Wolf Farm


B & R Drilling Company

990 Ft. from N. Line

Ft. from S. Line

Ft. from E. Line

660 Ft. from W. Line

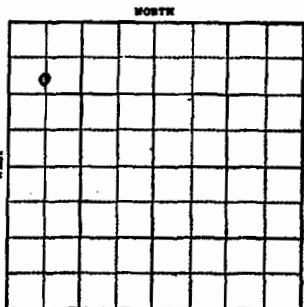

ELEV 2011

1943

10/27 Arb 3591
5" @ 3607
Perf. Lans
Water
T.D. 3609'

ABANDONED

1943 R E P O R T

9/8	Location
9/15	Any 1105-20 T.D. Run 10
9/22	8" @ 1120 Drlg. 1850'
9/29	Drlg. 2805'
10/6	Lans 3273 Arb 3569 ReArb 3569 Drlg. 3577'
10/13	Cong 3502 Arb 3591 Correded T.D. 3607 5" @ 3607 Sta. Rust Perf.
10/20	T.D. 3609 Plug 3400-7 shots 3371-76

OVER

KANSAS

FORM 51 5M PETROL

Ellis

Section 16 Township 15 Range 18-W

Well No. #1 Wolf

Company B & R Drilling

