

Map No. _____ Sec. 16 Twp. 15 R. 18WWell No. 1 RothAnderson & Prichard CompanyFIRST REPORT Contractor


SE SW

SECTION PLAT

_____ Ft. from N. Line

330 Ft. from S. Line330 Ft. from E. Line

_____ Ft. from W. Line

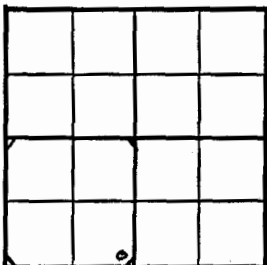

Ellis County

Location _____

Rig up _____

Drilling and Remarks:

Anhy 1205

8" @ 1220

RECORD

Cased _____ in., _____ ft.

Sand _____

Gas _____

Oil _____

Total Depth _____

PRODUCTION

1st 24 hrs. Nat. _____

1st 24 hrs. after shot _____

Gas _____ Cu. Ft.

Dry Hole _____

Abandoned _____

Date

APR 20 1949 19

S. J. LEWIS Scout

Map No. H 74 Sec. 16 Twp. 15 R. 18WWell No. 1 RothAnderson-Prichard CompanyABANDONED Contractor


SE SW

SECTION PLAT

_____ Ft. from N. Line

330 Ft. from S. Line330 Ft. from E. Line

_____ Ft. from W. Line

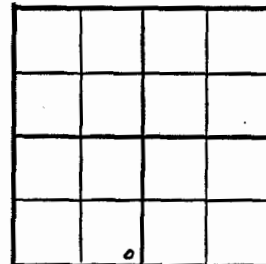

Ellis County

Location _____

Rig up _____

Drilling and Remarks:

Core 3608.
5-3442.

RECORD

Cased _____ in., _____ ft.

Sand _____

Gas _____

Oil _____

Total Depth 3628 in. Core

PRODUCTION

1st 24 hrs. Nat. _____

1st 24 hrs. after shot _____

Gas _____ Cu. Ft.

Dry Hole _____

Abandoned _____

Date

MAY 11 1949 19

S. J. LEWIS Scout

KANSAS

Ellis

Sec. 16 Twp. 15 R. 18W

Well No. #1 Roth Farm

Anderson & Prichard


Wildcat Company

_____ Ft. from N. Line

330' Ft. from S. Line

330' Ft. from E. Line

_____ Ft. from W. Line

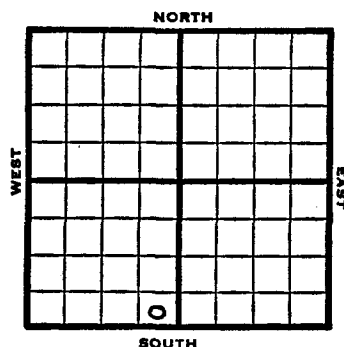

SE SW

1949 Elev 2045' REPORT

4/20 Anhy. 1205'
8" @ 1220'

4/27 Drlg 3153'

5/8 Lansing 3333'
Cong 3608'
TD 3678 in Cong
SO&G
5" @ 3442'

5/11 TD 3678 in Cong
Cong 3608'
5" @ 3442'
Aband.

ABANDONED

KANSAS

Ellis

Section 16 Township 15 Range 18W

Well No. 1 Roth

Company Anderson-Prichard

Wildcat

