



ELLIS KANSAS

SEC. 16 TWP. 15 R. 18W


WELL NO. 1 Ohnmacht FARM

COMPANY Heathman & Seeligson

CONTRACTOR G-M-R

Schoenchen Pool

\_\_\_\_\_ Ft. from N. Line  
 330 \_\_\_\_\_ Ft. from S. Line  
 330 \_\_\_\_\_ Ft. from E. Line  
 \_\_\_\_\_ Ft. from W. Line

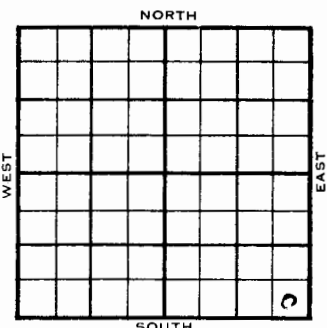

SE SE SE Lafayette & Gulf DHM - Duke & Wood Farmout

1953 ELEVATION 2037' REPORT

12/9 MIR  
 12/16 8" @ 197 w/110  
 Anhy 1185'  
 Drlg. 3162'  
 1954  
 1/27 Spud 12-9-53  
 Oil Well  
 TD 3623'  
 8" @ 197'  
 Anhy 1185', Heeb 3270', Tor 3290',  
 Lans 3316'  
 DST 3334'-48' opn 55 min, rec 75' Mud  
 off  
 DST 3360'-76' opn 1 hr, rec 942' wtr  
 600# Arb 3616'  
 DST 3580'-3620' opn 1 hr, rec 40' Mud  
 off  
 DST 3617'-23' opn 1 1/2 hr, rec 20' Mud  
 5' mco, off  
 TD 3623'  
 5" @ 3618'  
 CO to 3623' B/ 1 goph 500 A  
 S/ 3-1/3 boph 1 1/4 hr, 1000 A  
 Comp 75 bopd. **COMPLETED**

FORM 51 Ellis KANSAS

Section 16 Township 15 Range 18W

Well No. 1 Ohnmacht

Company Heathman & Seeligson

