

Map No. 74 Sec. 17 Twp. 15 R. 18WWell No. 6 RuderPalmer & Dal Company

Contractor

SECTION PLAT

			0

330 Ft. from N. Line

_____ Ft. from S. Line

_____ Ft. from E. Line

990 Ft. from W. Line

FIRST REPORT

Location _____

Rig up _____

Drilling and Remarks:

Building rig

RECORD

Cased _____ in., _____ ft.

Sand _____

Gas _____

Oil _____

Total Depth _____

PRODUCTION

1st 24 hrs. Nat. _____

1st 24 hrs. after shot _____

Gas _____ Cu. Ft.

Dry Hole _____

Abandoned _____

Date

JUN 17 1936

19

S. J. LEWIS

Scout

Map No. 74 Sec. 17 Twp. 15 R. 18WWell No. 6 RuderPalmer & Dal Company

Contractor

SECTION PLAT

			0

330 Ft. from N. Line

_____ Ft. from S. Line

_____ Ft. from E. Line

990 Ft. from W. Line

Location _____

Rig up _____

Drilling and Remarks:

Si 635801000 acidPor 8508 galsTrace water

RECORD

Cased _____ in., _____ ft.

Sand _____

Gas _____

Oil _____

Total Depth 2592.

PRODUCTION

1st 24 hrs. Nat. _____

1st 24 hrs. after shot _____

Gas _____ Cu. Ft.

Dry Hole _____

Abandoned _____

Date

JUL 22 1936

19

S. J. LEWIS

Scout

Ellis

Map No. KANSAS Sec. 17 Twp. 15 R. 18W

Well No. #6 Ruder Farm

Palmer et al Company


330' Ft. from N. Line

Ft. from S. Line

Ft. from E. Line

990' Ft. from W. Line

Elev. 2006

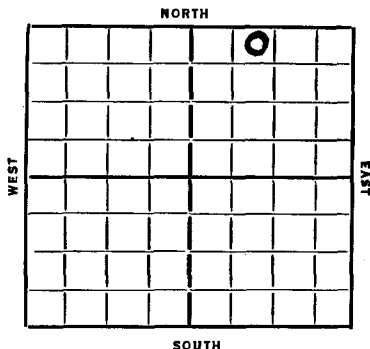

Date 1936 REPORT

6/17 Building rig.

6/25 Drlg. 1150'.

7/2 Drlg. 2500'.

7/9 Set 7" @ 3583'. R.U.S.T.

7/16 Sil. 3580'. Saturation 3580-83'.

Rigging up standard tools.

7/22/36-Sil. 3580'.

T.D. 3592'.

Potential 808 bbls of oil and
a trace of water.

COMPLETED

KANSAS

Form 51-5M-4-36-Palace

Ellis

Section 17 Township 15 Range 18-W

Well Number #6-Ruder

Company Palmer et al

