

KANSAS

Map No. 74 Sec. 17 Twp. 15 R. 18W

Well No. 3 Ruder

Tom Palmer + Stormking Company
Contractor

SECTION PLAT

		o	

990 Ft. from N. Line
..... Ft. from S. Line
..... Ft. from E. Line
330 Ft. from W. Line

RECORD

Location.....
Cased..... in., ft.
Rig up.....
Sand.....
Gas.....
Oil.....
Drilling and Remarks:
B. Rat. Rig
Total Depth.....

PRODUCTION

1st 24 hrs. Nat.....
1st 24 hrs. after shot.....
Gas..... Cu. Ft.
Dry Hole.....
Abandoned.....

Date 12-11-35 192..... Scout

Map No. 74 Sec. 17 Twp. 15 R. 18W

Well No. 3 - Ruder

Palmer + Stormking Company
Contractor

COMPLETE

SECTION PLAT

		o	

990 Ft. from N. Line
..... Ft. from S. Line
..... Ft. from E. Line
330 Ft. from W. Line

RECORD

Location.....
Cased..... in., ft.
Rig up.....
Sand Covered 3237
Gas.....
Oil.....
Drilling and Remarks:
1000 and
Total Depth 3291

PRODUCTION

1st 24 hrs. Nat.....
1st 24 hrs. after shot.....
Gas..... Cu. Ft.
Dry Hole.....
Abandoned.....

Date 1-16-36 192..... Scout

Map No. 74 **KANSAS** Sec. 17 Twp. 15 R. 18W

Well No. 3 Ruder

Palmer & Dal Company

Contractor

SECTION PLAT

		0	

990 Ft. from N. Line

_____ Ft. from S. Line

_____ Ft. from E. Line

330 Ft. from W. Line

FIRST REPORT

OW III

Location _____

Rig up _____

Drilling and Remarks:

066713291

CO.

RECORD

Cased _____ in., _____ ft.

Sand _____

Gas _____

Oil _____

Total Depth _____

PRODUCTION

1st 24 hrs. Nat. _____

1st 24 hrs. after shot _____

Gas _____ Cu. Ft.

Dry Hole _____

Abandoned _____

Date

JUN 17 1936 19

S. J. LEWIS

Scout

Map No. 74 **KANSAS** Sec. 17 Twp. 15 R. 18W

Well No. 3 Ruder

Palmer & Dal Company

Contractor

SECTION PLAT

		0	

990 Ft. from N. Line

_____ Ft. from S. Line

_____ Ft. from E. Line

330 Ft. from W. Line

COMPLETED

Location _____

Rig up _____

Drilling and Remarks:

Oil 3554
Completed on old
Pa 81506

RECORD

Cased _____ in., _____ ft.

Sand _____

Gas _____

Oil _____

Total Depth 3554

PRODUCTION

1st 24 hrs. Nat. _____

1st 24 hrs. after shot _____

Gas _____ Cu. Ft.

Dry Hole _____

Abandoned _____

Date

JUL 29 1936 19


S. J. LEWIS

Scout

Map No. **KANSAS** Sec. 17 Twp. 15 R. 18^W

Well No. 3-Ruder Farm
Tom Palmer & Stoucking Company

990 Ft. from N. Line
Ft. from S. Line
Ft. from E. Line
330 Ft. from W. Line

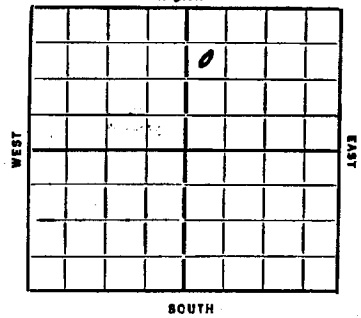

Elev. 1988

7/29/36-Sil. 3551'.
T.D. 3554'.
Completed on old potential.
1506 bbls of oil.

COMPLETED

REPORT **O. W. D. D**

~~12/14~~ B. Rot Rig
12/18 TD 810 drilling 12"
1/26 Dlg 1100
7/2/36 " 2550
8/10 Top Dew. 3237
to 3275-85 8" 3275
TD 3291 3150' OSH
1200' at 1 1/2 hrs.
1/16 Reveld 3237
TD 3291
1000 acid
1506 Bbls.

COMPLETED

O. W. D. D


~~1/17~~ O.T.D. 3291'
CLEANING OUT.

6/25--Sil. 3549'. Drlg. 3554'.
7/2 T.D. 3549'. 3554' No test
7/9--7/16--7/23-- **OVER**

Ellis

Map No. **KANSAS** Sec. *17* Twp. *15* R. *18W*

Well No. *3-Ruder* Farm
John Palmer & Stormking Company

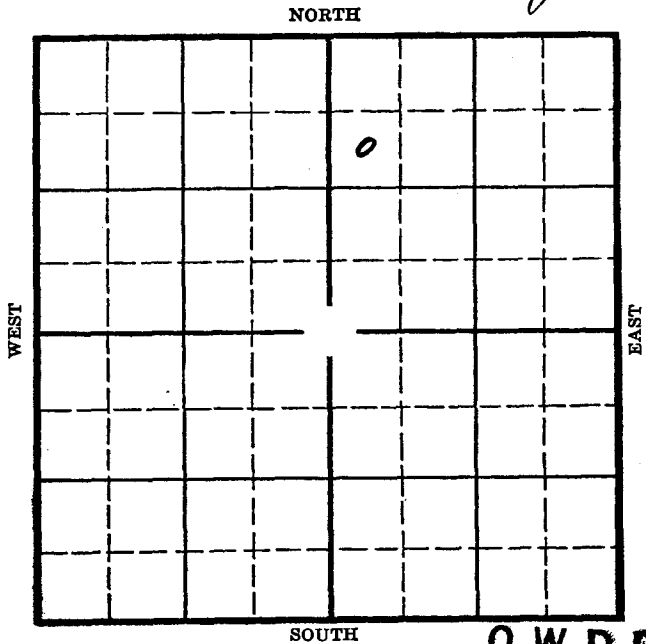

O. W. D. D

Location _____
 Drilling Remarks _____

Rig Up _____
 Drilling Remarks _____

RECORD

PRODUCTION

Cased _____ in. _____ ft.
 Sand _____
 Gas _____
 Oil _____
 Total Depth _____

1st 24 hrs. Nat. _____
 1st 24 hrs. after shot _____
 Gas _____ cu. ft. _____
 Dry Hole _____
 Abandoned _____