

Ellis

Map No. 17 Sec. 15 Twp. 18 R. W


Well No. 1- Ruler Farm
Palmer et al Company

990 Ft. from N. Line

_____ Ft. from S. Line

330 Ft. from E. Line

_____ Ft. from W. Line

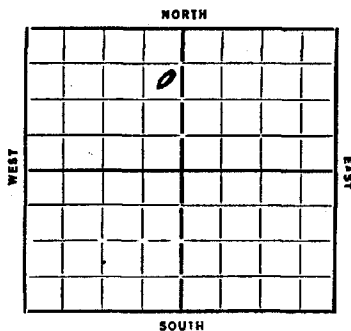

1935 O.W.D.D
8/21 OT 7 3429
T 7 34 40
pull 8" run 6"

8/28 T 7 3440
818 lbs.

Date	REPORT	O. W. D. D
4/24	Ellis	
5/2	Rig	
5/9	Rgn	
5/16	Dly 500	
5/23	" 1020	
5/29	" 1134	
6/6	12 1/2 1134	
6/13	Dly 1300	
6/20	" 2085	
6/28	" 2480	
7/3	" 2675	
7/11	HFW 2975 HFW 3055-56	
	Revol 3248	
7/18	8" 3248 ASD 3255-57	
	Water 3285-90	
	AS 3322-25	
	3346 Inc Oil & Water	
8/8	Dly 3405	
8/14	Revol 3248 T 7 3429	
	1000 acid	
	499 lbs 1% Water	
	COMPLETED	

COMPLETED

Form 28-100 Rev. 9-28 **KANSAS**
Map No. 74 Sec. 17 Twp. 15 R. 18W
Well No. 1-Ruder
Palmer et al Company
Contractor

FIRST REPORT

SECTION PLAT

990 Ft. from N. Line

..... Ft. from S. Line

330 Ft. from E. Line

..... Ft. from W. Line

	0		

Location.....

Rig up.....

Drilling and Remarks:

clean

RECORD
Cased..... in., ft.
Sand.....
Gas.....
Oil.....
Total Depth.....

PRODUCTION
1st 24 hrs. Nat.....
1st 24 hrs. after shot.....
Gas..... Cu. Ft.
Dry Hole.....
Abandoned.....

Date 4-24-35 192..... **ORVAL MANNSCHRECK**
Scout

Form 28-100 Rev. 9-28 **KANSAS**
Map No. 74 Sec. 17 Twp. 15 R. 18W
Well No. 1-Ruder
Palmer et al Company
Contractor

COMPLETION

SECTION PLAT

990 Ft. from N. Line

..... Ft. from S. Line

330 Ft. from E. Line

..... Ft. from W. Line

	0		

Location.....

Rig up.....

Drilling and Remarks:

1000 auto

*H 99 lbs
10% water*

RECORD
Cased..... in., ft.
~~Sand~~ *swirl* 324.3
Gas.....
Oil.....
Total Depth..... 3429

PRODUCTION
1st 24 hrs. Nat.....
1st 24 hrs. after shot.....
Gas..... Cu. Ft.
Dry Hole.....
Abandoned.....

Date 8-14-35 192..... **ORVAL MANNSCHRECK**
Scout

KANSAS

Map No. 74 Sec. 17 Twp. 15 R. 18WWell No. 1-RuderPalmer et al Company

Contractor

SECTION PLAT

	0		

990 Ft. from N. Line

Ft. from S. Line

330 Ft. from E. Line

Ft. from W. Line

Qwdd

Location

Rig up

Drilling and Remarks:

OTD 3429Td 3440pull 8"
Cem 6"

RECORD

Cased.....in.,ft.

Sand.....

Gas.....

Oil.....

Total Depth.....

PRODUCTION

1st 24 hrs. Nat.....

1st 24 hrs. after shot.....

Gas.....Cu. Ft.

Dry Hole.....

Abandoned.....

Date

8-21-35 192

Scout

KANSAS

Map No. 74 Sec. 17 Twp. 15 R. 18WWell No. 1-RuderPalmer & Stormking Company

Contractor

SECTION PLAT

	0		

990 Ft. from N. Line

Ft. from S. Line

330 Ft. from E. Line

Ft. from W. Line

Qwdd

Location

Rig up

Drilling and Remarks:

818 fth

RECORD

Cased.....in.,ft.

Sand.....

Gas.....

Oil.....

Total Depth 3440

PRODUCTION

1st 24 hrs. Nat.....

1st 24 hrs. after shot.....

Gas.....Cu. Ft.

Dry Hole.....

Abandoned.....

Date

8-28-35 192

Scout

ORVAL MANNSCHRECK

Form 51—5M—5-21-1936
 Map No. KANSAS Sec. 17 Twp. 15 R. 18^W
 Well No. 15 Ruder Farm
Palmer et al Company

Form 51—5M—5-21-1936
 Map No. KANSAS Sec. 17 Twp. 15 R. 18^W
 Well No. 15 Ruder Farm
Palmer et al Company

Well No. 1- Kuder Farm
Palmer Stab Company


[illegible]