

Map No. 74 Sec. 17 Twp. 15 R. 18W

Map No. 74 Sec. 17 Twp. 15 R. 18W

Well No. 1 - J. C. Ruder

Well No. 1 - J. C. Ruder

Texas Company

Texas Company

Contractor

Contractor

SECTION PLAT

	0		

330 Ft. from N. Line

\_\_\_\_\_ Ft. from S. Line

330 Ft. from E. Line

\_\_\_\_\_ Ft. from W. Line

FIRST REPORT

Location \_\_\_\_\_

Rig up \_\_\_\_\_

Drilling and Remarks:

NO G

RECORD

Cased \_\_\_\_\_ in., \_\_\_\_\_ ft.

Sand \_\_\_\_\_

Gas \_\_\_\_\_

Oil \_\_\_\_\_

Total Depth \_\_\_\_\_

PRODUCTION

1st 24 hrs. Nat. \_\_\_\_\_

1st 24 hrs. after shot \_\_\_\_\_

Gas \_\_\_\_\_ Cu. Ft.

Dry Hole \_\_\_\_\_

Abandoned \_\_\_\_\_

Date

FEB 10 1937

19

S. J. LEWIS Scout

ABANDONED

SECTION PLAT

	0		

330 Ft. from N. Line

\_\_\_\_\_ Ft. from S. Line

330 Ft. from E. Line

\_\_\_\_\_ Ft. from W. Line

Location \_\_\_\_\_

Rig up \_\_\_\_\_

Drilling and Remarks:

P.O. 3295

2000 A.

DVA

RECORD

Cased 7 in., 3568 ft.

Sand 511 3569

Gas \_\_\_\_\_

Oil \_\_\_\_\_

Total Depth 3588

PRODUCTION

1st 24 hrs. Nat. \_\_\_\_\_

1st 24 hrs. after shot \_\_\_\_\_

Gas \_\_\_\_\_ Cu. Ft.

Dry Hole \_\_\_\_\_

Abandoned \_\_\_\_\_

Date


JUN 30 1937

H. D. Hatfield

Scout

Sec. 17 Twp. 15 R. 18 W  
 Well No. #1 J. C. Ruder Farm  
Texas Company

330 Ft. from N. Line  
 \_\_\_\_\_ Ft. from S. Line  
330 Ft. from E. Line  
 \_\_\_\_\_ Ft. from W. Line

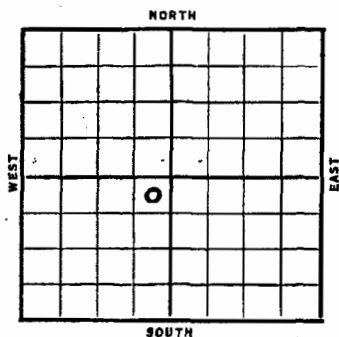

*Elev. 1987*

Date	REPORT
1937	
2/10	R O G
2/19	Building rig.
2/26	Rigging up.
3/4	20" @ 52'. Drlg. 960'.
3/11	12" @ 1144' WOC
3/18	Drlg. 2435'.
3/25	KCL 3265' set 8". T.D. 3270' RUST.
4/2	" " "
4/8	Drlg. 3300'.
4/16	Drlg. 3403'
4/23	Drlg. 3535'.
4/30	Cong. 3552'. Sil. 3569'. Show oil 3570'. U.R. 7".
5/7	" " "
5/14	7" @ 3568'. T.D. 3488'. P.B. 3465'.
5/21	P.B. 3440'.
5/28	Pump 4 bbls. oil and 20 water 24 hrs. S.D.O.
6/4	P.B. 3286'.
<b>OVER</b>	

1937  
 6/11 P.B. 3286'.  
 6/19 T.D. 3295'.  
 2000 acid. Testing.  
 6/25 " " " "

6/30 7" @ 3568'.  
 Sil. 3569'.  
 T.D. 3588'.  
 P.B. 3295'.  
 2000 acid.

ABANDONED

Section 17 Township 15 Range 18-W

Well Number 1 J. C. Ruder

Company Texas

