

Ellis

KANSAS


SEC.	TWP.	R.
20	15	18W

WELL NO. #1 Klaus FARM

COMPANY Victor Drlg.

CONTRACTOR Victor Drlg.

Ruder Pool

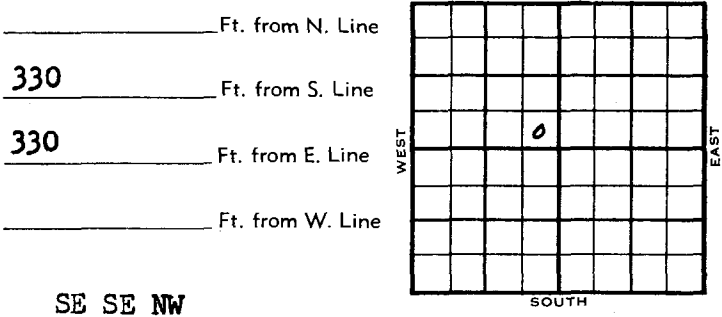

SE SE NW

	ELEVATION	REPORT
1954	1975'	

5/26 Spud 5-18-54
 Anhy 1143'
 8" @ 1145'
 Drlg 2458'

6/2 Spud 5-18-54
 D&A
 TD 3630'
 Anhy 1143'
 8" @ 1145'
 Heeb 3221', Lans 3267', B KC 3498'
 DST 3587-3602', opn 1/2 hrs., rec. 1070'
 wcm, 120' sw, 1100'
 Arb. 3609'
 TD 3630'
 D&A

ABANDONED

DX-78

DX 78-1

Ellis Kansas

Section 20 Township 15 Range 18W

Well No. 1 Klaus

Company Victor Drlg.

