

KANSAS

Map No. 74 Sec. 21 Twp. 15 R. 18W

Well No. 1 Roth

Lion Oil & Ref. Company
Contractor

SECTION PLAT

0			

330 Ft. from N. Line
____ Ft. from S. Line
____ Ft. from E. Line
330 Ft. from W. Line

FIELD REPORT

Location _____

RECORD

Cased _____ in., _____ ft.
Sand _____
Gas _____
Oil _____
Total Depth _____

PRODUCTION

1st 24 hrs. Nat. _____
1st 24 hrs. after shot _____
Gas _____ Cu. Ft.
Dry Hole _____
Abandoned _____

Date

MAY 27 1936

19

Scout

Map No. 74 Sec. 21 Twp. 15 R. 18W

Well No. 1 Roth

Lion Oil & Ref. Company
Contractor

SECTION PLAT

0			

330 Ft. from N. Line
____ Ft. from S. Line
____ Ft. from E. Line
330 Ft. from W. Line

ABANDONED

Location _____

RECORD

Cased _____ in., _____ ft.
Sand _____
Gas _____
Oil _____
Total Depth 3610

PRODUCTION

1st 24 hrs. Nat. _____
1st 24 hrs. after shot _____
Gas _____ Cu. Ft.
Dry Hole _____
Abandoned _____

Date

AUG 12 1936

19

S. J. LEWIS

Scout

Ellis

Ellis

Map No. **KANSAS** Sec. **81** Twp. **15** R. **18W**



Section **21** Township **15** Range **18W**

Well No. **#1 Roth** Farm _____
Lion Oil & Ref. Company

Well Number **#1 Roth**

Company **Lion Oil & Ref.**

330' Ft. from N. Line
_____ Ft. from S. Line
_____ Ft. from E. Line
330' Ft. from W. Line

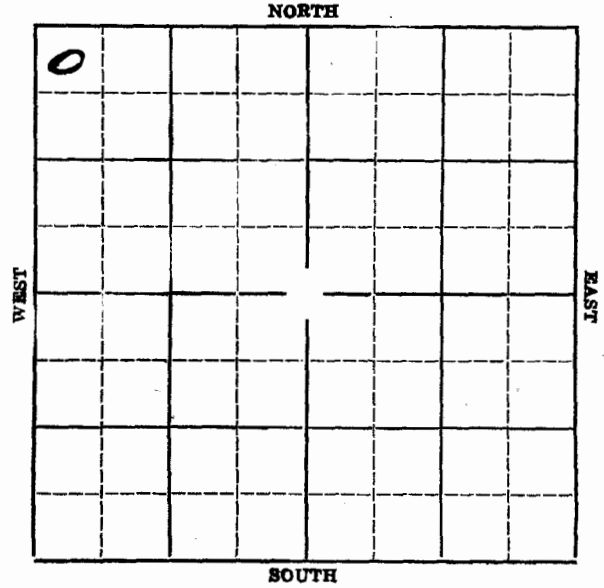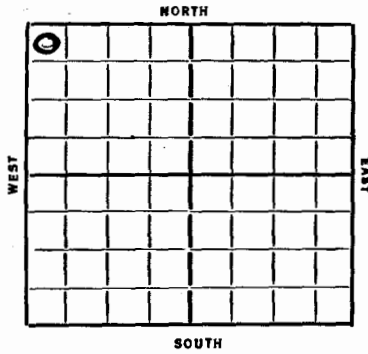

1936	<i>Elev 2015</i>	REPORT
5/27	Building rig.	
6/4--6/11--		
6/18	Drlg. 500'.	
6/25	Drlg. 1187'.	
7/2	Drlg. 2225'.	
7/9	Drlg. 2750'.	
7/16	Lansing 6270'. 8" @ 3270'. T.D.	
	3283'. Rigging up standard tools.	
7/23	--	
7/30	3298'. (CORRECTED LANSING) Drlg.	
	3468'.	
8/6	Drlg. 3468'	
8/12/36	Sil. 3595'.	
	T.D. 3610'.	
	Hole full of water 3608'.	
	Dry and abandoned.	
	ABANDONED	