

Kansas

Map No. 1571 Sec. 21 Twp. 15 R. 18W

Well No. 2 Engel

H. H. & B. Drlg. Company

FIRST REPORT

Contractor

NE SE NE

SECTION PLAT

			o

_____ Ft. from N. Line

990 Ft. from S. Line

330 Ft. from E. Line

_____ Ft. from W. Line

Ellis County

Location X

RECORD

Cased _____ in., _____ ft.

Sand _____

Gas _____

Oil _____

Total Depth _____

PRODUCTION

1st 24 hrs. Nat. _____

1st 24 hrs. after shot _____

Gas _____ Cu. Ft.

Dry Hole _____

Abandoned _____

Date

MAR 26 1947 19 S. J. LEWIS Scout

Kansas

Map No. 1574 Sec. 21 Twp. 15 R. 18W

Well No. 2 Engel

H. H. & B. Drlg. Company

ABANDONED

Contractor

NE SE NE

SECTION PLAT

			o

_____ Ft. from N. Line

990 Ft. from S. Line

330 Ft. from E. Line

_____ Ft. from W. Line

Ellis County

Location _____

RECORD

Cased _____ in., _____ ft.

Sand _____

Gas _____

Oil _____

Total Depth 3618

PRODUCTION

1st 24 hrs. Nat. _____

1st 24 hrs. after shot _____

Gas _____ Cu. Ft.

Dry Hole _____

Abandoned _____

Date

APR 16 1947 19 S. J. LEWIS Scout

Ellis KANSAS

Sec. 21 Twp. 15N R. 18W

Well No. 2 Inge1 Engel Farm

H. H. & B. Drlg. Company

Leiker Pool


Ft. from N. Line

990 Ft. from S. Line

330 Ft. from E. Line

Ft. from W. Line

NE SE NE

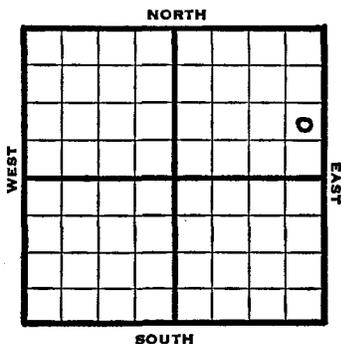

1947 Elev. 1972 REPORT

3/26 Location.

4/2 Anhydrite 1186'
8" @ 1195'
Drlg. 2413'.

4/9 Lans 3287
Arb 3599
TD 3604'
5" @ 3600'
RUST

4/16 Lans 3287
Arb. 3599'
TD 3618'

ABANDONED

KANSAS Ellis

Section 21 Township 15 Range 18W

Well No. 2 Inge1 Engel

Company H. H. & B. Drlg.

Leiker NORTH

