

Map No. K74 Sec. 21 Twp. 15 R. 18W

Well No. 3 Engle

H. H. & B. Company


FIRST REPORT

Contractor

C S L N E S E

SECTION PLAT

990 Ft. from N. Line
 Ft. from S. Line
660 Ft. from E. Line
 Ft. from W. Line

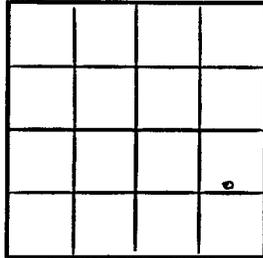

Ellis County

Location _____

Rig up _____

Drilling and Remarks:

Anhy 1156
8" @ 1161
drlg. 2200

RECORD

Cased _____ in., _____ ft.
Sand _____
Gas _____
Oil _____
Total Depth _____

PRODUCTION

1st 24 hrs. Nat. _____
1st 24 hrs. after shot _____
Gas _____ Cu. Ft.
Dry Hole _____
Abandoned _____

Date _____

MAY 7 1947 19

S. J. LEWIS Scout

Map No. K74 Sec. 21 Twp. 15 R. 18W

Well No. 3 Engle

H. H. & B. Company


ABANDONED

Contractor

C S L N E S E

SECTION PLAT

990 Ft. from N. Line
 Ft. from S. Line
660 Ft. from E. Line
 Ft. from W. Line

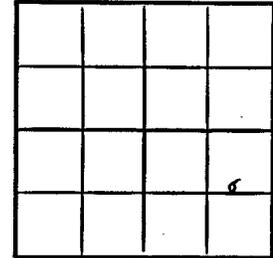

Ellis County

Location _____

Rig up _____

Drilling and Remarks:

Per 3594

RECORD

Cased _____ in., _____ ft.
Sand _____
Gas _____
Oil _____
Total Depth 9612

PRODUCTION

1st 24 hrs. Nat. _____
1st 24 hrs. after shot _____
Gas _____ Cu. Ft.
Dry Hole _____
Abandoned _____

Date _____

MAY 21 1947 19

S. J. LEWIS Scout

KANSAS

Ellis county ✓

Sec. 21 Twp. 15 R. 18W

Well No. 3 Engle Farm _____

H. H. & B. Company _____

Leiker Pool


990 Ft. from N. Line

_____ Ft. from S. Line

660 Ft. from E. Line

_____ Ft. from W. Line

C S L N E S E

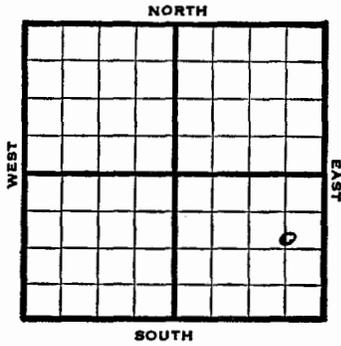

Year	Report
1947	Elev. 2004 REPORT
5/7	A Anhy 1156 3" @ 1161' Drlg. 2200'.
5/13	Drlg. 3455'
5/21	Arb 3594 TD 3612' ABANDONED

Ellis

KANSAS

Section 21 Township 15 Range 18W

Well No. 3 Engle

Company H. H. & B.

