

Sec. 22 Twp. 15 R. 18W

Well No. #1 Zimmerman Farm

Sunray Oil Company

Anschutz Drlg. Contractor
Schoenchen Pool


990 Ft. from N. Line

Ft. from S. Line

660 Ft. from E. Line

Ft. from W. Line


C S L NE NE

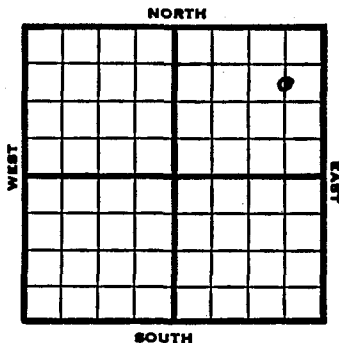

Section 22 Township 15 Range 18W

Well No. #1 Zimmerman

Company Sunray Oil

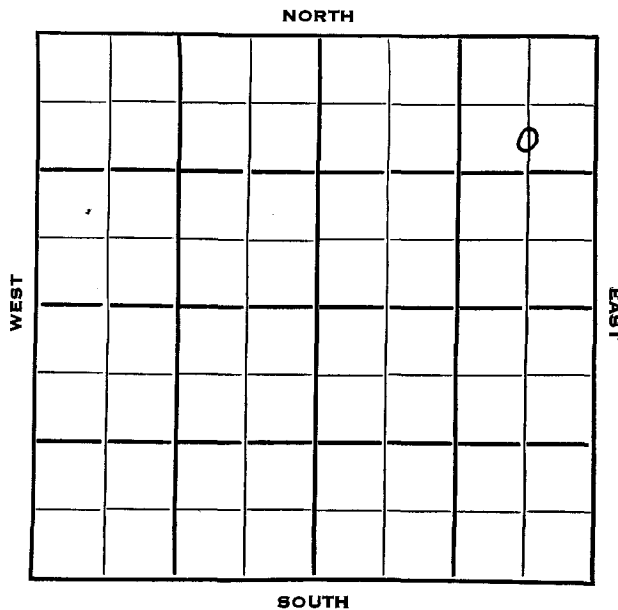

1953 Elev. 2010' REPORT

4/22 MIRT

4/30 Anhy 1158
8" @ 1167
Drlg. 2445f

5/7 Top 2965, Heeb 3251, Tor 3270, Lans 3294,
DST 3307-45 opn 1 hr, 525' SW 1105#
B KC 3528, Cong 3572, Arb 3595,
RTD 3597 Schl.
5" @ 3595'

5/13 Spud 4-21-53
D & A
TD 3599'
Anhy 1158
8" @ 1167'
Top. 2965, Heeb 3251, Tor. 3270, Lans 3294,
DST 3307-45 opn 1 hr, rec 525' sw 1105#
B KC 3528 Cong 3572, Arb 3595,
TD 3597
5" @ 3595'
CO to 3597 5 goph 6 hr. 500 A 3 goph
dec. to 1 goph DD 3599 5 goph 1000 A
S/ 20 bw 1 hr.
D & A.

ABANDONED