

Kansas Pool Name Wildcat

Map No. 76 Sec. 22 Twp. 15 R. 18W


Well No. 1 Zimmerman

Gulf Company

FIRST REPORT Contractor

SW NW

SECTION PLAT

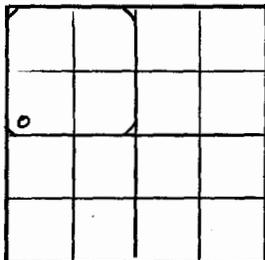

Ft. from N. Line

330 Ft. from S. Line

Ft. from E. Line

330 Ft. from W. Line

Ellis County

Location _____

Rig up _____

Drilling and Remarks:

R U R

RECORD

Cased _____ in., _____ ft.

Sand _____

Gas _____

Oil _____

Total Depth _____

PRODUCTION

1st 24 hrs. Nat. _____

1st 24 hrs. after shot _____

Gas _____ Cu. Ft.

Dry Hole _____

Abandoned _____

Date

AUG 7 1946 19 S. J. LEWIS Scout

KANSAS

Schoenschen Pot

Map No. 74 Sec. 22 Twp. 15 R. 18W


Well No. 1 Zimmerman

Gulf Company

COMPLETED Contractor

SW NW

E1 2034
SECTION PLAT

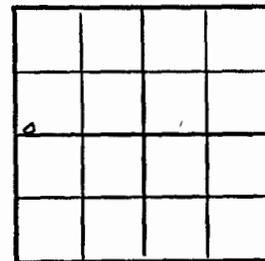

Ft. from N. Line

330 Ft. from S. Line

Ft. from E. Line

330 Ft. from W. Line

Ellis County

Location _____

Rig up _____

Drilling and Remarks:

Per 3581

5' @ 3572

5000 acid

Pump 714 Bx

27 9/16

RECORD

Cased _____ in., _____ ft.

Sand _____

Gas _____

Oil _____

Total Depth 3572

PRODUCTION

1st 24 hrs. Nat. _____

1st 24 hrs. after shot _____

Gas _____ Cu. Ft.

Dry Hole _____

Abandoned _____

Date

OCT 23 1946 19 S. J. LEWIS Scout

KANSAS

Ellis County



Sec. 22 Twp. 15 R. 18W

Well No. #1 Zimmerman Farm

Gulf Company

Wildcat


Ft. from N. Line

330 Ft. from S. Line

Ft. from E. Line

330 Ft. from W. Line

SW NW

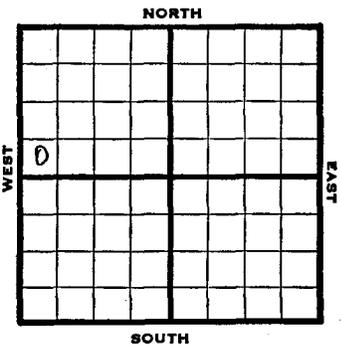

1946 2034 REPORT

8/7 RUR
 8/13 Anhy 1188
 8" @ 1193
 Drlg 1576'
 8/20 Land 3286
 Arb 3568
 TD 3571 SSO, run csg
 8/27 SLM 3571-84 TD
 Lans 3299
 Arb 3581
 5" @ 3582, RUST
 9/5 TD 3598'
 2000 acid,
 Pump 270 oil in 15 hrs.
 9/10 " " "
 9/18 " " "
 9/24 " " "
 10/1 " " "
 10/8 Pump 111 oil in 10 hrs
 10/15 Pump 242 oil in 12 hrs no wtr.
 10/23 Arb 3581'
 5" @ 3582'
 5000 Acid
 TD 3598'
 Pump 714 POT
 Gr. 27

COMPLETED

Ellis County

Section 22 Township 15 Range 18W

Well No. 1 Zimmerman

Company Gulf

