

Schoenschen

Form 26 200 Bks. 10-46 Petrol
Kansas

Map No. 74 Sec. 22 Twp. 15 R. 18W


Well No. 2 J. Zimmerman

Gulf Company

FIRST REPORT

SW SE NW Contractor

SECTION PLAT

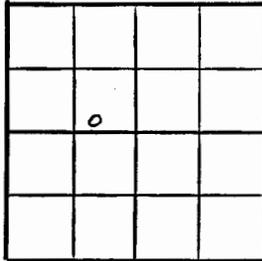

_____ Ft. from N. Line

330 Ft. from S. Line

990 Ft. from E. Line

_____ Ft. from W. Line

Ellis County

Location <u>X</u>	RECORD
Rig up _____	Cased _____ in., _____ ft.
Drilling and Remarks:	Sand _____
	Gas _____
	Oil _____
	Total Depth _____
	PRODUCTION
	1st 24 hrs. Nat. _____
	1st 24 hrs. after shot _____
	Gas _____ Cu. Ft.
	Dry Hole _____
	Abandoned _____

Date OCT 30 1946 19 S. J. LEWIS Scout

Form 26 200 Bks. 10-46 Petrol
Kansas **KANSAS** Schoenschen Pool

Map No. 74 Sec. 22 Twp. 15 R. 18W


Well No. 2 J. Zimmerman

Gulf Company

COMPLETED

SW SE NW Contractor E12046

SECTION PLAT

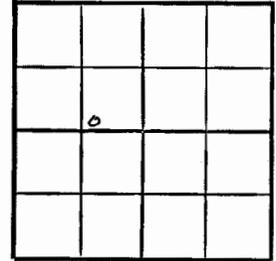

_____ Ft. from N. Line

330 Ft. from S. Line

990 Ft. from E. Line

_____ Ft. from W. Line

Ellis County

Location _____	RECORD
Rig up _____	Cased _____ in., _____ ft.
Drilling and Remarks:	Sand _____
<u>Per 83627</u>	Gas _____
<u>5" @ 8627</u>	Oil _____
<u>Pump 29 oil + 87 oil</u>	Total Depth <u>3629</u>
<u>BD.</u>	PRODUCTION
	1st 24 hrs. Nat. _____
	1st 24 hrs. after shot _____
	Gas _____ Cu. Ft.
	Dry Hole _____
	Abandoned _____

Date JAN 2 1947 19 S. J. LEWIS Scout

KANSAS Ellis county

Sec. 22 Twp. 15 R. 18-W

Well No. #2, J. Zimmerman Farm

Gulf Company

Schoenschen


Ft. from N. Line

330' Ft. from S. Line

990' Ft. from E. Line

Ft. from W. Line

SW SE NW

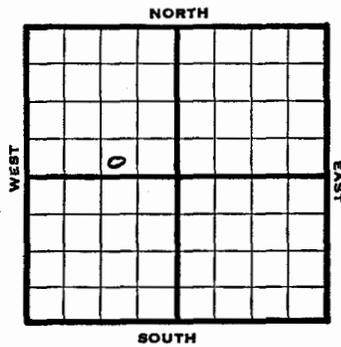

1946 Elev. 2046' REPORT

10/30 Location.
 11/6 8" @ 1198', WOC
 11/12 Drlg 3260'
 11/20 Arb 3627'
 TD 3629'
 5" @ 3627, RUST
 11/27 " "
 12/3 Swb 12 oil plus 12 W in 12 hrs
 12/10 " " "
 12/17 " " "
 1947
 1/2 Arb 3627'
 5" @ 3627'
 TD 3629'
 Pump 29 oil plus 8 % W POT
 24 Grav.

COMPLETED

Ellis county

Section 22 Township 15 Range 18-W

Well No. #2, J. Zimmerman

Company Gulf Oil Company

