

Ellis County Kansas State

Ellis County Kansas State

Map No. Sec. 22 Twp. 15 R. 18W

Map No. 74 Sec. 22 Twp. 15 R. 18W

Well No. 3 Zimmerman

Well No. 3 Zimmerman

Gulf Company

Gulf Company

FIRST REPORT Contractor

COMPLETE Contractor

NE SW NW

NE SW NW

SECTION PLAT

SECTION PLAT

Ft. from N. Line

Ft. from N. Line

990 Ft. from S. Line

990 Ft. from S. Line

Ft. from E. Line

Ft. from E. Line

990 Ft. from W. Line

990 Ft. from W. Line

Schorchne Pool

Schoechne Pool

Remarks:

Remarks:

Location

Cr 8626
 6" @ 8627
 703629
 1000 and
 Pump 215 oil + 40% W 84
 24 2 94

Date JUL 28 1948

Scout S. J. LEWIS

Date SEP 22 1948

Scout S. J. LEWIS

Sec. 22 Twp. 15 R. 18W

Well No. #3 Zimmerman Farm _____

Company Gulf

Schorchne Pool


_____ Ft. from N. Line

990' Ft. from S. Line

_____ Ft. from E. Line

990' Ft. from W. Line

NE SW NW

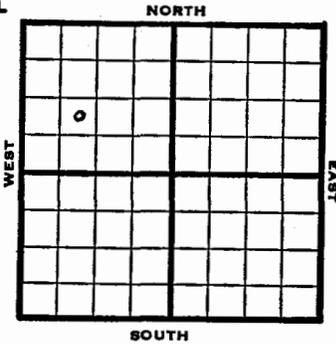

1948 Elev. 2044' REPORT

7/28 Location
 8/4 "
 8/11 10" @ 1199'
 Drlg 3135 &
 Arb. 3626'
 8/18 TD 3628'
 6" @ 3627'
 8/24 1000 acid
 Swb 108 bbls oil 2 1/4 hrs.
 7% W
 9/1 "
 9/8 "
 9/14 "
 9/22 Arbuckle 3626'
 6" @ 3627'
 1000 acid
 Pump 215 oil & 40% W Pot.
 Gr. 24°
 TD 3629'

COMPLETED

Section 22 Township 15 Range 18W

Well No. 3 Zimmerman

Company Gulf

