

Map No. _____ Sec. 22 Twp. 15 R. 18W


Well No. 2 Zimmerman

Jones & Shelborne Company

INLET REPORT Contractor

SE SW NE

SECTION PLAT

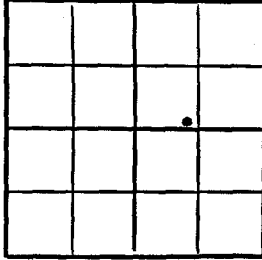

_____ Ft. from N. Line

330 Ft. from S. Line

_____ Ft. from E. Line

990 Ft. from W. Line

Ellis County

Location _____

RECORD

Cased _____ in., _____ ft.

Sand _____

Gas _____

Oil _____

Total Depth _____

PRODUCTION

1st 24 hrs. Nat. _____

1st 24 hrs. after shot _____

Gas _____ Cu. Ft.

Dry Hole _____

Abandoned _____

8" @ 214

drlg. 3150

Date

JAN 19 1949 19 S. J. LEWIS Scout

Map No. K74 Sec. 22 Twp. 15 R. 18W


Well No. 2 Zimmerman

Jones & Shelborne Company

COMPLETE Contractor

SE SW NE

SECTION PLAT

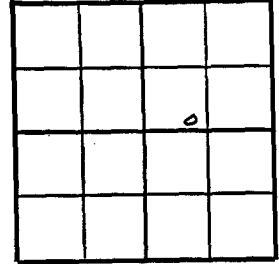

_____ Ft. from N. Line

330 Ft. from S. Line

_____ Ft. from E. Line

990 Ft. from W. Line

Ellis County

Location _____

RECORD

Cased _____ in., _____ ft.

Sand _____

Gas _____

Oil _____

Total Depth 3619

PRODUCTION

1st 24 hrs. Nat. _____

1st 24 hrs. after shot _____

Gas _____ Cu. Ft.

Dry Hole _____

Abandoned _____

Per 3610

5' @ 3606

1000 acid

Pump 25 oil PT

3150

Date

FEB 16 1949 19 S. J. LEWIS Scout



Sec. 22 Twp. 15 R. 18 W

Well No. #2 Zimmerman Farm

Jones & Shelborne Company

Madden Pool


Ft. from N. Line

330' Ft. from S. Line

Ft. from E. Line

990' Ft. from W. Line

SE SW NE

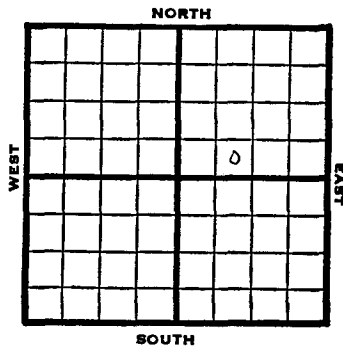

1949 Elev. 2046' REPORT

- 1/19 8" @ 214'
- 1/27 Drlg. 3150'
- Lansing 3314'
- Arb 3612-16'
- TD 3616'
- 5" @ 3604'
- 2/2 "
- 2/9 TD 3619
- 1000 acid
- 2/16 Arb. 3610'
- 5" @ 3606'
- 1000 acid
- Pump 75 oil Pot.
- Gr. 31°
- TD 3619'

COMPLETED

Section 22 Township 15 Range 18W

Well No. 2 Zimmerman

Company Jones & Shelborne

Madden

