

Map No. \_\_\_\_\_ Sec. 22 Twp. 15 R. 18W

Well No. 1 Zimmerman


Jones & Shelborne Company

FIRST REPORT

Contractor

SE NE

SECTION PLAT

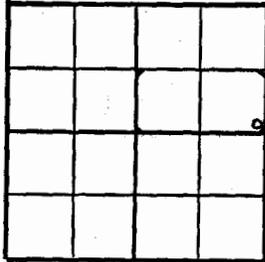

\_\_\_\_\_ Ft. from N. Line  
330 \_\_\_\_\_ Ft. from S. Line  
330 \_\_\_\_\_ Ft. from E. Line  
\_\_\_\_\_ Ft. from W. Line

Ellis County

Location \_\_\_\_\_

Rig up \_\_\_\_\_

Drilling and Remarks:

8" @ 205

drlg. 3946

RECORD

Cased \_\_\_\_\_ in., \_\_\_\_\_ ft.

Sand \_\_\_\_\_

Gas \_\_\_\_\_

Oil \_\_\_\_\_

Total Depth \_\_\_\_\_

PRODUCTION

1st 24 hrs. Nat. \_\_\_\_\_

1st 24 hrs. after shot \_\_\_\_\_

Gas \_\_\_\_\_ Cu. Ft.

Dry Hole \_\_\_\_\_

Abandoned \_\_\_\_\_

Date

DEC 15 1948 19

S. J. LEWIS Scout

Map No. 7A Sec. 22 Twp. 15 R. 18W

Well No. 1 Zimmerman

Jones & Shelborne Company


COMPLETE

Contractor

SE NE

E12016

SECTION PLAT

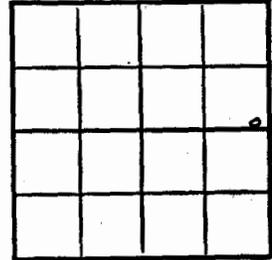

\_\_\_\_\_ Ft. from N. Line  
330 \_\_\_\_\_ Ft. from S. Line  
330 \_\_\_\_\_ Ft. from E. Line  
\_\_\_\_\_ Ft. from W. Line

Ellis County

Location \_\_\_\_\_

Rig up \_\_\_\_\_

Drilling and Remarks:

Cr 73565

5" @ 3569

Pump 100 ml Per

25-46

RECORD

Cased \_\_\_\_\_ in., \_\_\_\_\_ ft.

Sand \_\_\_\_\_

Gas \_\_\_\_\_

Oil

Total Depth 3824

PRODUCTION

1st 24 hrs. Nat. \_\_\_\_\_

1st 24 hrs. after shot \_\_\_\_\_

Gas \_\_\_\_\_ Cu. Ft.

Dry Hole \_\_\_\_\_

Abandoned \_\_\_\_\_

Date

JAN 5 1949 19

S. J. LEWIS Scout

KANSAS

Ellis

Sec. 22 Twp. 15 R. 18W ✓

Well No. #1 Zimmerman Farm

Jones & Shelborne

Company

Madden Pool


\_\_\_\_\_ Ft. from N. Line

330' Ft. from S. Line

330' Ft. from E. Line

\_\_\_\_\_ Ft. from W. Line

SE NE

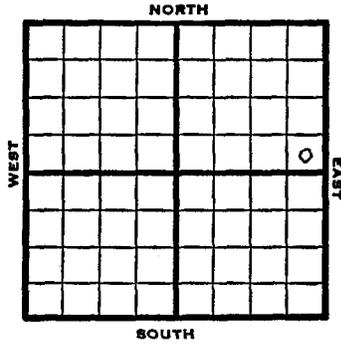


KANSAS Ellis

Section 22 Township 15 Range 18W

Well No. 1 Zimmerman

Company Jones & Shelborne

Madden Pool

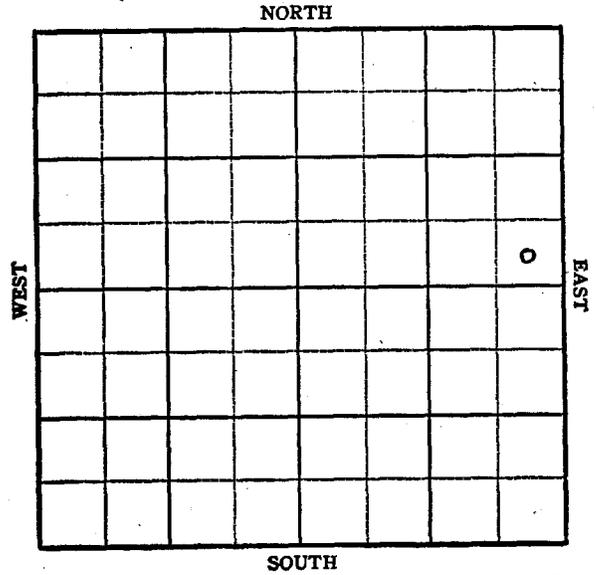

1948 Elev. 2016' REPORT

12/15 8" @ 205'  
12/22 Drlg. 3946'  
Arb 3568'-74'  
TD 3574  
5" @ 3569'

1949  
1/5 Arb. 3568'  
5" @ 3569'  
Pump 100 oil Pot.  
Gr. 28°  
TD 3574'

**COMPLETED**