

Map No. Sec. 22 Twp. 15 R. 18W

Well No. 4 Pivonka

Jones & Shelborne Company

Jones & Shelborne Contractor

NW NE SE


FIRST REPORT
SECTION PLAT

330 Ft. from N. Line

 Ft. from S. Line

990 Ft. from E. Line

 Ft. from W. Line

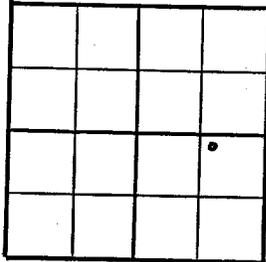

Ellis County

Location

Rig up

Drilling and Remarks:

surface hole

RECORD

Cased in., ft.

Sand

Gas

Oil

Total Depth

PRODUCTION

1st 24 hrs. Nat.

1st 24 hrs. after shot

Gas Cu. Ft.

Dry Hole

Abandoned

Date

NOV 16 1949

19

S. J. LEWIS

Scout

Map No. Sec. 22 Twp. 15 R. 18W

Well No. 4 Pivonka

Jones & Shelborne Company

ABANDONED Contractor

NW NE SE


E12037
SECTION PLAT

330 Ft. from N. Line

 Ft. from S. Line

990 Ft. from E. Line

 Ft. from W. Line

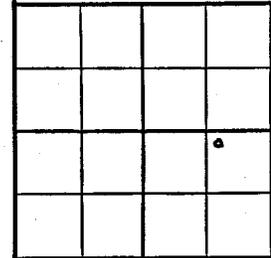

Ellis County

Location

Rig up

Drilling and Remarks:

Line 3319
Qty 3623

RECORD

Cased in., ft.

Sand

Gas

Oil

Total Depth 3625

PRODUCTION

1st 24 hrs. Nat.

1st 24 hrs. after shot

Gas Cu. Ft.

Dry Hole

Abandoned

Date

NOV 30 1949

19

S. J. LEWIS

Scout

Ellis

KANSAS

Sec. 22 Twp. 15 R. 18W

Well No. #4 Pivonka Farm

Jones & Shelborne Company

Madden Pool (Jones & Shelborne, Contr.)


330' Ft. from N. Line

_____ Ft. from S. Line

990' Ft. from E. Line

_____ Ft. from W. Line

NW NE SE

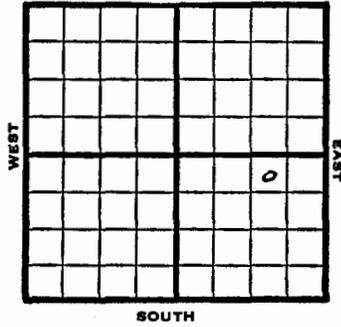


KANSAS Ellis

Section 22 Township 15 Range 18-W

Well No. #4 Pivonka

Company Jones & Shelborne
Madden Pool

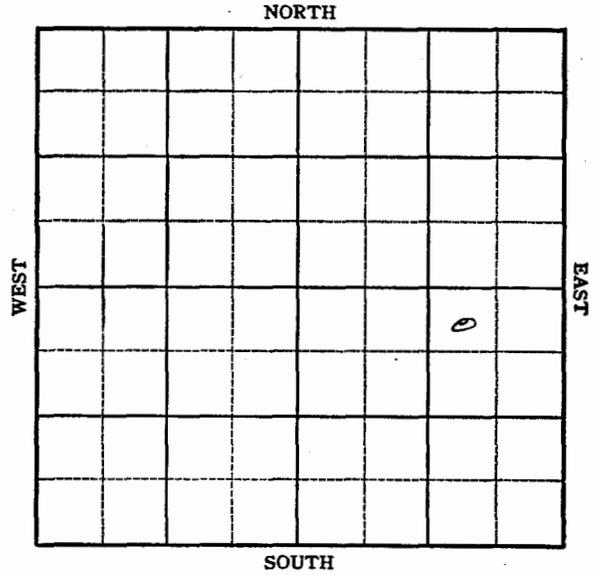

1949 Elev 2027' REPORT

11/16 Surface Hole
 11/23 8" @ 1187'
 Drlg 2740'
 11/30 TD 3675'
 Lansing 3319'
 Arb. 3623'
 Aband.
ABANDONED