

KANSAS Kansas Pool Name Wildcat
 Map No. 78 Sec. 21 Twp. 15 R. 18W
 Well No. 1 Povonka

H & H & B Drlg. Company

FIRST REPORT Contractor

NE NW SW


SECTION PLAT

330 Ft. from N. Line

_____ Ft. from S. Line

_____ Ft. from E. Line

990 Ft. from W. Line

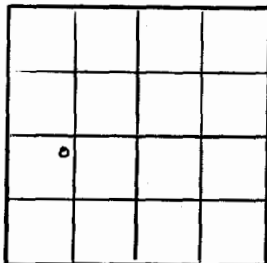

Ellis County

Location X

Rig up _____

Drilling and Remarks:

RECORD

Cased _____ in. _____ ft.

Sand _____

Gas _____

Oil _____

Total Depth _____

PRODUCTION

1st 24 hrs. Nat. _____

1st 24 hrs. after shot _____

Gas _____ Cu. Ft.

Dry Hole _____

Abandoned _____

Date

SEP 5 1946 19 S. J. LEWIS Scout

KANSAS Kansas Pool Name None
 Map No. 78 Sec. 22 Twp. 15 R. 18W
 Well No. 1 Povonka

H & H & B Drlg. Company

CORRECTION Contractor

NE NW SW


SECTION PLAT

330 Ft. from N. Line

_____ Ft. from S. Line

_____ Ft. from E. Line

990 Ft. from W. Line

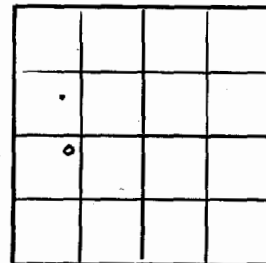

Ellis County

Location _____

Rig up _____

Drilling and Remarks:

Reported in

21-15-18W

RECORD

Cased _____ in. _____ ft.

Sand _____

Gas _____

Oil _____

Total Depth _____

PRODUCTION

1st 24 hrs. Nat. _____

1st 24 hrs. after shot _____

Gas _____ Cu. Ft.

Dry Hole _____

Abandoned _____

Date

SEP 5 1946 19 S. J. LEWIS Scout

Map No. 76 Sec. 22 Twp. 15 R. 18W

Well No. 1 Povonka


H H & B Drkg. Company

COMPLETED

Contractor

NE NW SW

E 1,2045
SECTION PLAT

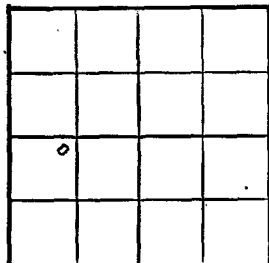

330 Ft. from N. Line

 Ft. from S. Line

 Ft. from E. Line

990 Ft. from W. Line

Ellis County

Location

Rig up

Drilling and Remarks:

Ar 3614
5" @ 3615
1500 acid
Pump 559 POT
33 Grav.

RECORD

Cased in., ft.

Sand

Gas

Oil

Total Depth 3617

PRODUCTION

1st 24 hrs. Nat.

1st 24 hrs. after shot

Gas Cu. Ft.

Dry Hole

Abandoned

Date

NOV 13 1946 19 S. J. LEWIS Scout

Ellis

Sec. 21 22 KANSAS Twp. 15-S R. 18-W

Well No. #1, Povonka Farm

H & H & B drilling Company


330' Ft. from N. Line

 Ft. from S. Line

 Ft. from E. Line

990' Ft. from W. Line

NE NW SW

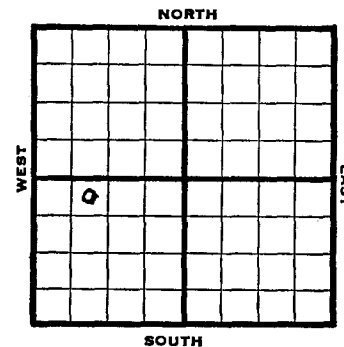

1946 2045 REPORT

9/5 Location

9/10 RUR

9/18 8" @ 1190'

Anhy 1192'

Drkg 1440'

9/24 Drkg 3196'

10/1 Lans 3317'

Cong 3605'

Arb 3614'

TD3617'

5" @ 3615' RUST

10/8 1500 acid

Swb 16 oil PH 4 hrs

10/15 " " "

10/22 " " "

10/29 " " "

11/6 " " "

11/13 Arb 3614'

5" @ 3615'

TD 3617'

1500 Acid

Pump 559 POT

33 Grav.

COMPLETED

Ellis county

FORM 51 5M 6-46 PETROL

KANSAS

Section 22
21 Township 15 Range 18-W

Well No. #1, Povonka

Company H&H B Drilling Company

