

S. J. LEWIS Scout

KANSAS Ellis ✓

Sec. 22 Twp. 15 R. 18W

Well No. 3 Pivonka Farm

Jones & Shelborne Company


Schoechne Pool

990 Ft. from N. Line

Ft. from S. Line

330 Ft. from E. Line

Ft. from W. Line

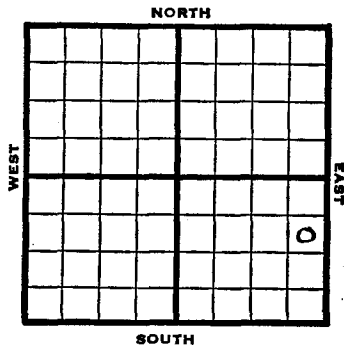

SE NE SE

1948 Elev. 2012' REPORT

9/22 Location

9/29 "

10/6 "

10/13 "

10/19 8" @ 221'

Drlg 1685'

10/26 Topeka 2984

Lansing 3272'

Arb. 3564

TD 3565

SO

5" @ 3564

11/3 "

11/10 TD 3572'

100' oil - 1 hr.

11/17 Arb 3564'

5" @ 3564'

Pump 50 oil Pot.

Gr. 27

TD 3572'

COMPLETED

KANSAS Ellis

Section 22 Township 15 Range 18W

Well No. 3 Pivonka

Company Jones & Shelborne

Schoechne Pool

