

Map No. _____ Sec. 21 Twp. 15 R. 18W


Well No. 1 Pivonka "B"

Anderson-Prichard Company

FIRST REPORT Contractor

SE NW SE

SECTION PLAT

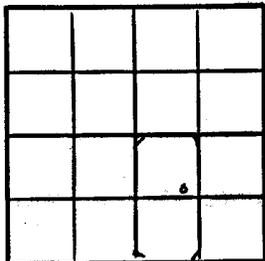

990 Ft. from N. Line

Ft. from S. Line

Ft. from E. Line

990 Ft. from W. Line

Ellis County

Location _____

RECORD

Cased _____ in., _____ ft.

Sand _____

Gas _____

Oil _____

Total Depth _____

PRODUCTION

1st 24 hrs. Nat. _____

1st 24 hrs. after shot _____

Gas _____ Cu. Ft.

Dry Hole _____

Abandoned _____

Drilling and Remarks:
R U R

Date

NOV 23 1948 19

S. J. LEWIS Scout

Map No. 74 Sec. 22 Twp. 15 R. 18W


Well No. 1 Pivonka "B"

Anderson-Prichard Company

CORRECTION Contractor

SE NW SE

SECTION PLAT

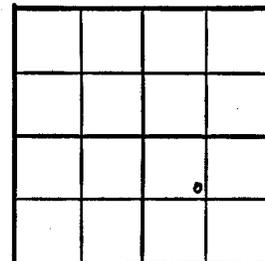

990 Ft. from N. Line

Ft. from S. Line

Ft. from E. Line

990 Ft. from W. Line

Ellis County

Location _____

RECORD

Cased _____ in., _____ ft.

Sand _____

Gas _____

Oil _____

Total Depth _____

PRODUCTION

1st 24 hrs. Nat. _____

1st 24 hrs. after shot _____

Gas _____ Cu. Ft.

Dry Hole _____

Abandoned _____

Drilling and Remarks:

Reported
21-15-18W

Date

DEC 1 1948 19

S. J. LEWIS Scout

Schoenchen Pool

Kansas

Map No. 74 Sec. 22 Twp. 15 R. 18W

Well No. 1 Pivonka "B"

Anderson-Prichard Company

COMPLETE

Contractor

SE NW SE


E1,2042
SECTION PLAT

990 Ft. from N. Line

_____ Ft. from S. Line

_____ Ft. from E. Line

990 Ft. from W. Line

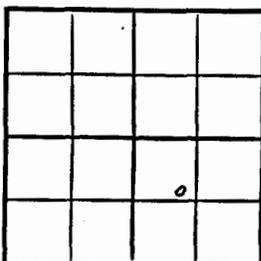

Ellis County

Location _____

Rig up _____

Drilling and Remarks:

Arb. 3592

500 acid

500 acid

Pump 99 oil Pot

283 bu

RECORD

Cased _____ in. _____ ft.

Sand _____

Gas _____

Oil

Total Depth 3606

PRODUCTION

1st 24 hrs. Nat. _____

1st 24 hrs. after shot _____

Gas _____ Cu. Ft.

Dry Hole _____

Abandoned _____

Date

JAN 12 1949 19

S. J. LEWIS Scout

22 KANSAS

Ellis

Sec. 22 Twp. 15 R. 18W ✓

Well No. #1 Pivonka "B" Farm _____

Anderson-Prichard Company

Schoenchen Pool


990' Ft. from N. Line

_____ Ft. from S. Line

_____ Ft. from E. Line

990' Ft. from W. Line

SE NW SE

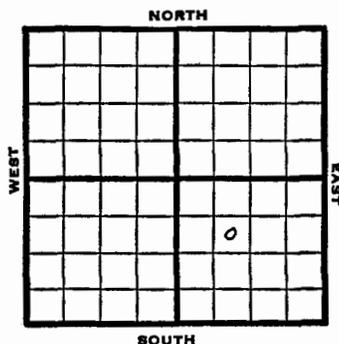

1948 Elev 2042' **REPORT**

11/23

RUR

11/30

"

12/8

9" @ 152'
Drlg 3185'

12/15

Lansing 3312
Arb. 3592'
TD 3606

12/22

5" @ 3595'
TD 3609'
500 acid
Swb 4 1/2 bbls oil PH 6 hrs.

12/29

1949

1/12

TD 3606'
Arb. 3592'
5" @ 3595'
500 acid
Pump 99 oil Pot
28' Gr.
Comp

COMPLETED

Section ²²~~21~~ Township 15 Range 18W

Well No. 1 Pivonka "B"

Company Anderson-Prichard

Schoenchen Pool

