

Map No. _____ Sec. 22 Twp. 15 R. 18WWell No. 3 Pivonka "B"

Anderson-Prichard Company

FIRST REPORT

Contractor

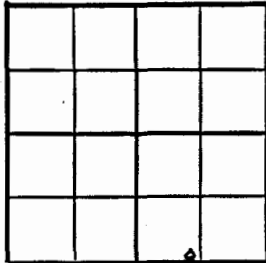
SE SW SE

SECTION PLAT

_____ Ft. from N. Line

330 Ft. from S. Line

_____ Ft. from E. Line

990 Ft. from W. Line

Ellis County

Location _____

RECORD

Cased _____ in., _____ ft.

Sand _____

Gas _____

Oil _____

Total Depth _____

PRODUCTION

1st 24 hrs. Nat. _____

1st 24 hrs. after shot _____

Gas _____ Cu. Ft.

Dry Hole _____

Abandoned _____

R U R

Date

MAR 9 1949 19 S. J. LEWIS Scout

Map No. 74 Sec. 22 Twp. 15 R. 18WWell No. 3 Pivonka "B"

Anderson-Prichard Company

ABANDONED

Contractor

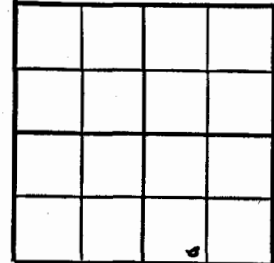
SE SW SE

SECTION PLAT

_____ Ft. from N. Line

330 Ft. from S. Line

_____ Ft. from E. Line

990 Ft. from W. Line

Ellis County

Location _____

RECORD

Cased _____ in., _____ ft.

Sand _____

Gas _____

Oil _____

Total Depth 2641

PRODUCTION

1st 24 hrs. Nat. _____

1st 24 hrs. after shot _____

Gas _____ Cu. Ft.

Dry Hole _____

Abandoned _____

Lam 3306

Crt 3612

Date

MAR 30 1949 19 S. J. LEWIS Scout

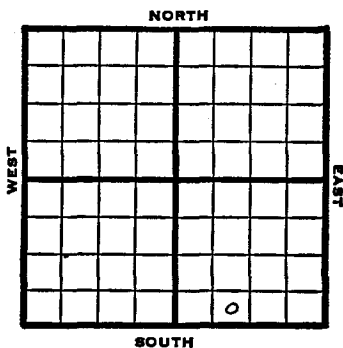
KANSAS

Ellis

Sec. 22 Twp. 15 R. 18W

Well No. #3 Pivonka "B" Farm

Anderson-Prichard Company
Madden Pool



Ft. from N. Line

330'

Ft. from S. Line

Ft. from E. Line

990' Ft. from W. Line

SE SW SE

1949 Elev 2014' REPORT

3/9 RUR
3/16 8" @ 1166'
Drlg 2445'

3/23 Lansing 3306'
Arbuckle 3612'
Drlg. 3618'

3/30 Lans 3306'
Arb 3612'
TD 3641'

ABANDONED

KANSAS

Ellis

Section 22 Township 15 Range 18W

Well No. 3 Pivonka "B"

Company Anderson-Prichard

Madden

