

Ellis KANSAS

O. W. D. D.

1955

Information brought forward.

1/5

OTD 3548'
DD 3555'
5" @ 3541' CO to 3552' 500 A
S. 39 bo 13 hr.
Cong. 3525'
Comp 19 bopd. 60% Wtr.


SEC.	23	TWP.	15	R.	18W
WELL NO.	1 Gross "A"				
COMPANY	FRONTIER OIL Jones Shelburne & Farmer				
CONTRACTOR	TRANSIT O. S. F.				
SE Leiker Pool					

330 _____ Ft. from N. Line

_____ Ft. from S. Line

_____ Ft. from E. Line

330 _____ Ft. from W. Line

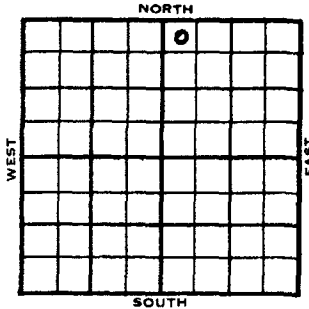

NW NW NE

COMPLETED

	ELEVATION	REPORT
1954	1959'	
7/21	7-19-54	Drlg. 874
8/4	Spud 7-19-54 - D&A	TD 3547'
	8" @ 1120'	
	Heeb 3201'; Tor 3223'; Lans 3249';	
	B KC 3476'; Cong 3525'; Arb. 3535'	
	DST 3539-42', opn 1/2 hrs., rec. 7'	
	mid, 940#	
	DST 3542-47', opn 1 hr., rec. 35' ocm,	
	Of	
	TD 3547'	
	D&A	
	ABANDONED	
	O. W. D. D.	
1954	Lans 3249', Arb. 3535'	
12/1	OTD 3548'	
	To DD	
1955	Oil Well	
1/5	TD 3555'	
	Lans 3249' Arb. 3538'	
	OVER	

DX-78

DX 7 **O.W.D.D**

Ellis KANSAS

O.W.W.O.

Section 23 Township 15 Range 18W

Well No. 1 Gross "A"

Company FRONTIER OIL
~~Jones, Shelburne & Farmer~~

