

Ellis KANSAS

O. W. D. D

1955

Information brought forward.

1/5

OTD 3548'
DD 3555'
5" @ 3541' CO to 3552' 500 A
S. 39 bo 13 hr.
Cong. 3525'
Comp 19 bopd. 60% Wtr.


| | | | | | |
|----------------|---|------|----|----|-----|
| SEC. | 23 | TWP. | 15 | R. | 18W |
| WELL NO. | 1 Gross "A" | | | | |
| COMPANY | FRONTIER OIL Jones Shelburne & Farmer | | | | |
| CONTRACTOR | TRANSIT O. S. F. | | | | |
| SE Leiker Pool | | | | | |

330 _____ Ft. from N. Line

_____ Ft. from S. Line

_____ Ft. from E. Line

330 _____ Ft. from W. Line

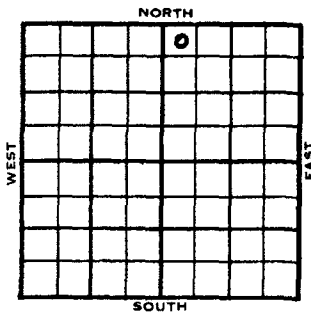

NW NW NE

COMPLETED

| | ELEVATION | REPORT |
|------|------------------------|---|
| 1954 | 1959' | |
| 7/21 | 7-19-54 | Drlg. 874 |
| 8/4 | Spud 7-19-54 - D&A | TD 3547' 8" @ 1120' Heeb 3201'; Tor 3223'; Lans 3249', B KC 3476', Cong 3525', Arb. 3535' DST 3539-42', opn 1/2 hrs., rec. 7' mud, 940# DST 3542-47', opn 1 hr., rec. 35' ocm, O# TD 3547' D&A |
| | | ABANDONED |
| 1954 | | O. W. D. D |
| 12/1 | Lans 3249', Arb. 3535' | OTD 3548' To DD |
| 1955 | | |
| 1/5 | Oil Well | TD 3555' Lans 3249' Arb. 3538' |

OVER

DX-78

County Ellis Elev. 1962 RB
 Sec. 23 Twp. 15 Rge. 18W
 Company Frontier Oil Co.
 Farm Name Gross "A" No. 1

| TOPS | DEPTH | LOG | DATUM | Loc. in Sec. |
|--------|-------------|-----|-------|--------------|
| Arb. | | | | NW NW NE |
| Tp. | | | | |
| H. | | | | |
| Tr. | | | | |
| Dg. | | | | |
| Bl. | | | | |
| L. | <u>3249</u> | | | Geol. |
| K.C. | | | | Contr. |
| B.K.C. | | | | |
| Ce. | <u>3525</u> | | | Pool |
| C. | | | | |
| M. | | | | |
| M. | | | | |
| K. | | | | |
| Mz. | | | | |
| Ma. | | | | |
| V. | | | | |
| S. | | | | |
| S. | | | | |
| A. | <u>3538</u> | | | |
| R. | | | | |
| PE. | | | | |
| G. | | | | |
| TD. | <u>3555</u> | | | |

FIRST REPORT
 SEP 19 50

Date Comm. 5" @ 3541 was Arb. Prod. PB 3370, perf 28/3336-43, 250A no rec. PB 3322, perf 48/3291-3303, 500A no rec, perf 48/3291-3303, 500A no rec, perf 40/3282-92, 2000A, Swb 5 BOPH-8 hrs, POP
 SEP 26 '56

County Ellis Elev. 1962 RB
 Sec. 23 Twp. 15 Rge. 18W
 Company Frontier Oil Co.
 Farm Name Gross "A" No. 1

| TOPS | DEPTH | LOG | DATUM | Loc. in Sec. |
|--------|-------------|-----|-------|--------------|
| Arb. | | | | NW NW NE |
| Tp. | | | | |
| H. | | | | |
| Tr. | | | | |
| Dg. | | | | |
| Bl. | | | | |
| L. | <u>3249</u> | | | Geol. |
| K.C. | | | | Contr. |
| B.K.C. | | | | |
| Ce. | <u>3525</u> | | | Pool |
| C. | | | | |
| M. | | | | |
| M. | | | | |
| K. | | | | |
| Mz. | | | | |
| Ma. | | | | |
| V. | | | | |
| S. | | | | |
| S. | | | | |
| A. | <u>3538</u> | | | |
| R. | | | | |
| PE. | | | | |
| G. | | | | |
| TD. | <u>3555</u> | | | |

SEP 26 '56
 COMPLETE

Date Comm. 5" @ 3541 was Arb. Prod. PB 3370, perf 28/3336-43, 250A no rec. PB 3322, perf 48/3291-3303, 500A no rec, perf 48/3291-3303, 500A no rec, perf 40/3282-92, 2000A, Swb 5 BOPH-8 hrs, POP
 SEP 26 '56 *Ph. P. 101 Bold*
no/water

DX 7 **O.W.D.D**

Ellis KANSAS

O.W.W.O.

Section 23 Township 15 Range 18W

Well No. 1 Gross "A"

Company FRONTIER OIL
~~Jones, Shelburne & Farmer~~

