

County Ellis Elev. _____				Co.
Sec. 23 Twp. 15 Rge. 18W				
Company Frontier Oil				
Farm Name GROSS "A"		No. 2		
TOPS	DEPTH	LOG	DATUM	Loc. in Sec.
Anh.				NE NW NE
Tr.				
De.				
Bl.				
L.				Geol. _____
K.C.				Contr. _____
B.K.C.				
Ce.				Trans-Era
C.				
M.				Pool _____
K.				
Mz.				
Me.				
V.				
S.				
S.				
A.				
R.				
PE.				
G.				
TD.				
Date Comm. drlg. 1796				No.
				Sec.
				T.
				R.

FIRST REPORT
APR 25 '56

County	Ellis	Elev	1978 RB
Sec.	23	Top	15
Company	Frontier Oil	Rge	18W
Farm Name	Gross "A"	No.	2

TOPS	DEPTH	LOG	DATUM	Loc. in Sec.
Anh.	1144			NE NW NE
Tr.	3213			
H.	3232			
Dg.				
Bl.				
L.	3259			Geol.
K.C.				Contx
B.K.C.	3485			Trans-Era
Ce.	3531			Pool
C.				
M.				
M.				
K.				
Mz.				
Ma.				
V.				
S.				
S.	3546			
A.				
R.				
PE				
G.				
TD	3552			

Date Comm. AUG 22 1956

drl. 1796 MAY 2 '56 4-20-56 8 5/8

1155 DST 3297-3309 90" 9 To

S. 15" rec 660' oil BHP 900 #

DST 3548-50 30' rec 7' Md BHP

2 DST 3549-52 45" rec 135'

OCM BHP 650 5/2 @ 3552 MAY 9 '56

WOST MAY 16 '56 CO 3552 8 4 Boph

no/w 6 hrs POP MAY 20 '56 MAY 25 '56

JUN 6 '56 JUN 12 '56 JUN 20 '56 JUN 27 '56 JUL 3 '56

Ph P. 95 Bopd no/w

AUG 1 '56 AUG 8 '56 AUG 15 '56 AUG 22 '56

A went to wt PD 3300
36/3292-3311 A 8 25
Boph no/w

Additional information

20-15-1" NE NW NE

Ellis

KANSAS

Ellis

KANSAS

SEC. 23	TWP. 15	R. 18W
---------	---------	--------

SECTION 23	TOWNSHIP 15	RANGE 18W
------------	-------------	-----------

WELL NO. #2 Grods "A" FARM

WELL NO. #2 Grods "A"

COMPANY Frontier Oil

COMPANY Frontier Oil

CONTRACTOR Trans-Era



_____ Ft. from N. Line

_____ Ft. from S. Line

_____ Ft. from E. Line

_____ Ft. from W. Line

NE NW NE

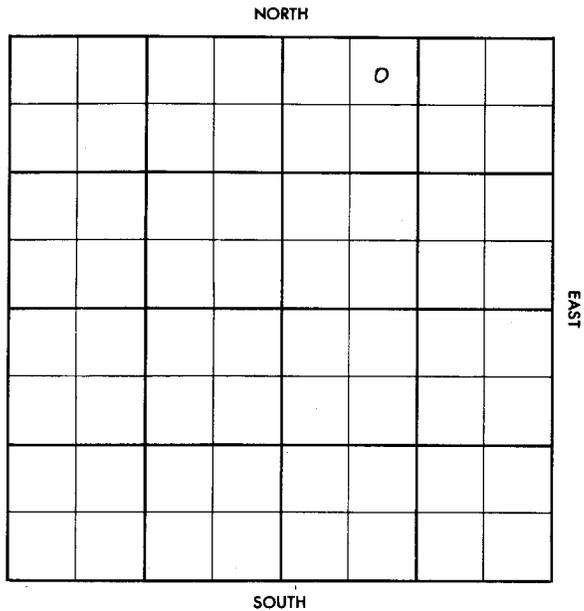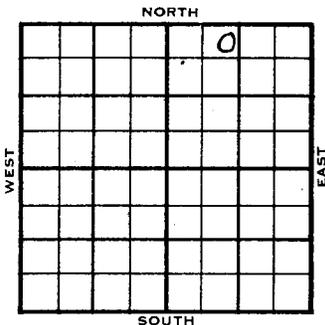

1956	ELEVATION 1978' RB	REPORT
------	--------------------	--------

4-25 Drlg. 1796

8-22 Comm. 4-20-56
 8 5/8" @ 155
 DST 3297-3309 op 90 min. gas to surf.
 15 min. rec. 660' oil, BHP 900#.
 DST 3548-50 op 30 min. rec. 7' mud,
 BHP 0#.
 DST 3549-52 op 45 min. rec. 135' OCM,
 BHP 650#.
 5 1/2" @ 3552
 CO 3552
 S/ 4 BOPH, no wtr., 6 hrs.
 P/ 95 BOPD, no wtr.
ADDITIONAL INFORMATION
 Went to water; PB 3360'
 36/3292-3311
 S/ 25 BOPH, no wtr.
 Anh. 11 1/4'; H. 3213'; Tr. 3232'; ##
 L. 3259'; BKC. 3485'; C. 3531'; ##
 A. 3546';
 TD 3552'

COMPLETED

DX-78