

Map No. \_\_\_\_\_ Sec. 23 Twp. 15 R. 18W

Well No. 1 Rutter


Jones & Shelborne Company

FIRST REPORT

Contractor

SW/C

SECTION PLAT

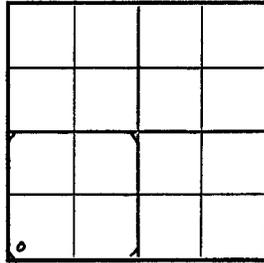

\_\_\_\_\_ Ft. from N. Line

330 Ft. from S. Line

\_\_\_\_\_ Ft. from E. Line

330 Ft. from W. Line

Ellis County

Location \_\_\_\_\_

Rig up \_\_\_\_\_

Drilling and Remarks:

8" @ 213

anhy 1130

drlg. 1160

RECORD

Cased \_\_\_\_\_ in., \_\_\_\_\_ ft.

Sand \_\_\_\_\_

Gas \_\_\_\_\_

Oil \_\_\_\_\_

Total Depth \_\_\_\_\_

PRODUCTION

1st 24 hrs. Nat. \_\_\_\_\_

1st 24 hrs. after shot \_\_\_\_\_

Gas \_\_\_\_\_ Cu. Ft.

Dry Hole \_\_\_\_\_

Abandoned \_\_\_\_\_

Date

MAY 12 1948

19

S. J. LEWIS

Scout

Map No. 74 Sec. 23 Twp. 15 R. 18W

Well No. 1 Rutter

Jones & Shelborne Company


COMPLETE

Contractor

SW/C

E. 1992

SECTION PLAT

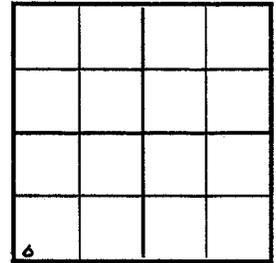

\_\_\_\_\_ Ft. from N. Line

330 Ft. from S. Line

\_\_\_\_\_ Ft. from E. Line

330 Ft. from W. Line

Ellis County

Location \_\_\_\_\_

Rig up \_\_\_\_\_

Drilling and Remarks:

*Core 43548*

*5" @ 3549*

*5000000*

*Produce 67 oil Prod*

*29 2/4*

RECORD

Cased \_\_\_\_\_ in., \_\_\_\_\_ ft.

Sand \_\_\_\_\_

Gas \_\_\_\_\_

Oil

Total Depth *3555*

PRODUCTION

1st 24 hrs. Nat. \_\_\_\_\_

1st 24 hrs. after shot \_\_\_\_\_

Gas \_\_\_\_\_ Cu. Ft.

Dry Hole \_\_\_\_\_

Abandoned \_\_\_\_\_

Date

JUL 14 1948

19


S. J. LEWIS

Scout

KANSAS Ellis 18 ✓  
Sec. 23 Twp. 15 R. 12W

Well No. #1 Ruther Farm  
Jones & Shelborne Company  
Madden Pool

\_\_\_\_\_ Ft. from N. Line  
330' Ft. from S. Line  
\_\_\_\_\_ Ft. from E. Line  
330' Ft. from W. Line  
SW/c

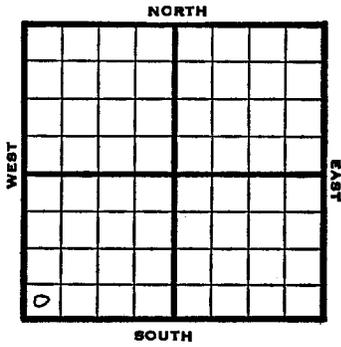

1948	El 1992'	REPORT
5/12	8" @ 213'	Anhy. 1130' Drlg. 1160'
5/26	Drlg. 3160'	
6/1	Lansing 3258'	Arbuckle 3548' TD 3651' 5" @ 3549' RUST
6/9	TD 3555'	-500 acid 1200( oil in 9 hrs.
6/16	"	
6/23	"	
6/29	"	
7/14	TD 3555'	Arb. 3548' 5"@ 3549' 500 acid Pump 67 Oil Pot 29° Gr. Comp. <b>COMPLETED</b>

KANSAS Ellis  
Section 23 Township 15 Range 18W

Well No. #1 Ruther RUDER  
Company Jones & Shelborne

