

Map No. \_\_\_\_\_ Sec. 23 Twp. 15 R. 18W


Well No. 4 Ruder

Jones Shelborne Company

FIRST REPORT Contractor

SE NW SW

SECTION PLAT

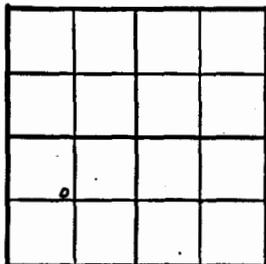

990 Ft. from N. Line

\_\_\_\_\_ Ft. from S. Line

\_\_\_\_\_ Ft. from E. Line

990 Ft. from W. Line

Ellis County

Location \_\_\_\_\_

Rig up \_\_\_\_\_

Drilling and Remarks:

8" @ 205  
drlg. 1080

RECORD

Cased \_\_\_\_\_ in., \_\_\_\_\_ ft.

Sand \_\_\_\_\_

Gas \_\_\_\_\_

Oil \_\_\_\_\_

Total Depth \_\_\_\_\_

PRODUCTION

1st 24 hrs. Nat. \_\_\_\_\_

1st 24 hrs. after shot \_\_\_\_\_

Gas \_\_\_\_\_ Cu. Ft.

Dry Hole \_\_\_\_\_

Abandoned \_\_\_\_\_

Date

DEC 22 1948 19

S. J. LEWIS Scout

Map No. 74 Sec. 23 Twp. 15 R. 18W


Well No. 4 Ruder

Jones & Shelborne Company

COMPLETE Contractor

SE NW SW

SECTION PLAT

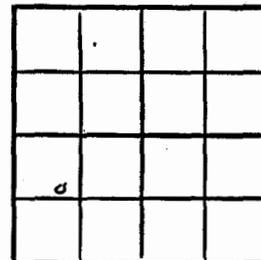

990 Ft. from N. Line

\_\_\_\_\_ Ft. from S. Line

\_\_\_\_\_ Ft. from E. Line

990 Ft. from W. Line

Ellis County

Location \_\_\_\_\_

Rig up \_\_\_\_\_

Drilling and Remarks:

*Cur 2005*  
*5" casing*  
*1000 acid*  
*Prod 100 oil*  
*25-26*

RECORD

Cased \_\_\_\_\_ in., \_\_\_\_\_ ft.

Sand \_\_\_\_\_

Gas \_\_\_\_\_

Oil

Total Depth *2025*

PRODUCTION

1st 24 hrs. Nat. \_\_\_\_\_

1st 24 hrs. after shot \_\_\_\_\_

Gas \_\_\_\_\_ Cu. Ft.

Dry Hole \_\_\_\_\_

Abandoned \_\_\_\_\_

Date


JAN 26 1949 19

S. J. LEWIS Scout

Sec. 23 Twp. 15 R. 18-W

Well No. #4 Ruder Farm  
Jones Shelborne Company  
Schoenchen

990 Ft. from N. Line  
\_\_\_\_ Ft. from S. Line  
\_\_\_\_ Ft. from E. Line  
990 Ft. from W. Line

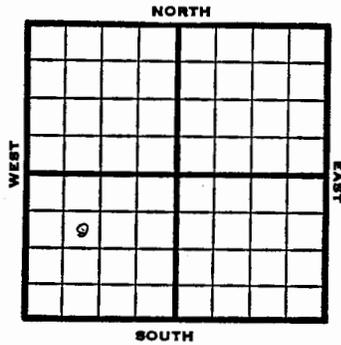

SE NW SW

1948 Elev. 2005' REPORT

- 12/22 8" @ 205'
- Drlg 1080'
- 12/29 Drlg 3030
- 1/5 Lansing 3357'
- Arbuckle 3557'
- TD 3263'
- 5" @ 3558'
- 1/12 TD 3575 Sw & 2 bbls oil PH
- 1/19 1000 acid
- 1/26 Arb. 3557'
- 5" @ 3558'
- 1000 acid
- Pump 100 oil Pot.
- Gr. 28°
- TD 3575'
- COMPLETED**

Section 23 Township 15 Range 18W

Well No. 4 Ruder

Company Jones Shelborne  
Schoenchen Pool

