

Map No. \_\_\_\_\_ Sec. 23 Twp. 15 R. 18W

Well No. 6 Ruder

Jones & Shelborne Company

Jones & Shelborne Contractor

SW NE SW

FIRST REPORT  
SECTION PLAT


990 Ft. from N. Line

Ft. from S. Line

990 Ft. from E. Line

Ft. from W. Line

Ellis County

Location \_\_\_\_\_

Rig up \_\_\_\_\_

Drilling and Remarks:

8" @ 244

Anhy 1169

drlg. 2320

RECORD

Cased \_\_\_\_\_ in., \_\_\_\_\_ ft.

Sand \_\_\_\_\_

Gas \_\_\_\_\_

Oil \_\_\_\_\_

Total Depth \_\_\_\_\_

PRODUCTION

1st 24 hrs. Nat. \_\_\_\_\_

1st 24 hrs. after shot \_\_\_\_\_

Gas \_\_\_\_\_ Cu. Ft.

Dry Hole \_\_\_\_\_

Abandoned \_\_\_\_\_

Date

SEP 7 1949 19

S. J. LEWIS Scout

Map No. \_\_\_\_\_ Sec. 23 Twp. 15 R. 18W

Well No. 6 Ruder

Jones & Shelborne Company

COMPLETE Contractor

SW NE SW

21,200  
SECTION PLAT


990 Ft. from N. Line

Ft. from S. Line

990 Ft. from E. Line

Ft. from W. Line

Ellis County

Location \_\_\_\_\_

Rig up \_\_\_\_\_

Drilling and Remarks:

*2 1/2" @ 357?*

*5" @ 357?*

*Progr. to 1748' W*

*Bo. J.*

*27° W*

RECORD

Cased \_\_\_\_\_ in., \_\_\_\_\_ ft.

Sand \_\_\_\_\_

Gas \_\_\_\_\_

Oil \_\_\_\_\_

Total Depth *2320*

PRODUCTION

1st 24 hrs. Nat. \_\_\_\_\_

1st 24 hrs. after shot \_\_\_\_\_

Gas \_\_\_\_\_ Cu. Ft.

Dry Hole \_\_\_\_\_

Abandoned \_\_\_\_\_

Date

DEC 21 1949 19

S. J. LEWIS Scout

Ellis KANSAS

Sec. 23 Twp. 15 R. 18W

Well No. #6 Ruder Farm

Jones & Shelborne


Madden Pool (Jones & Shelborne, Cont.) Company

990' Ft. from N. Line

Ft. from S. Line

990' Ft. from E. Line

Ft. from W. Line

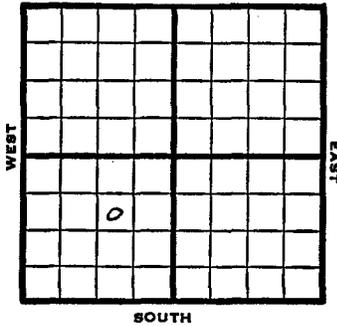

SW NE SW

1949	Elev 2000'	REPORT
9/7	8" @ 244'	Anhy 1169' Drlg. 2320'
9/14	Lansing 3265'	BKC 3507' Arb. 3577' TD 3582' Run 5"
9/21	5" @ 3577'	500 acid Drlg. 3584'
9/28	Swb 18 bbls oil /	LOW PH
10/5	"	"
10/12	"	"
10/19	"	"
10/26	"	"
11/1	"	"
11/9	"	"
11/16	"	"
11/23	"	"
11/29	"	"
12/7	"	"
12/14	"	"
12/21	TD 3595'	Arb. 3577' 5" @ 3577' Pump 24 Oil / 48% W Pot 270 Gr. Comp

COMPLETED

KANSAS

Ellis

Section 23 Township 15 Range 18W

Well No. 6 Ruder

Company Jones & Shelborne

Madden

