

County Ellis State Kans
 Sec. 23 (Blk. 15) (Sur. 18W) Map No.
 Operator Jones, Shelburne & Farmer
 Well No. 1 Farm Pfannensteil
 Elev. _____ Location NE SE SE
 990 Ft. From S Line SE
 330 Ft. From E Line Quarter
 1st. Report SEP 23 1953
 Completion _____
 Remarks Stanolind farmout
D & M Drlg. - Contr.
 Spudding Date 9-21-53
 Drlg. Data Bielman Pool

J. G. McGEHEE

County Ellis State Kansas
 Sec. 23 (Blk. 15) (Sur. 18W) Map No.
 Operator Jones, Shelburne & Farmer
 Well No. 1 Farm Pfannensteil
 Elev. 1956 Location NE SE SE
 990 Ft. From S Line SE
 330 Ft. From E Line Quarter
 1st. Report _____
 Completion DEC 2 1953
 Remarks Bielman Pool
D & M Drlg. - Contr.
 Spudding Date 9-21-53
 Drlg. Data Oil well TD 3548

8" @ 1000 Anhy 1125 Heeb. 3206
 Tor. 3225 Lans. 3243 Arb. 3542
 DST 3542-48 open 1 hr. Rec. 150' gas
 152' free oil 970# TD 3548 5" @ 3542
 CO to 3548 1 $\frac{1}{4}$ boph 10 hr. 300 A
 S/ 5 $\frac{1}{2}$ boph 6 hr. P/ 60 bfpd 65% wtr.
 Comp. 22 bopd 80% wtr.

J. G. McGEHEE

Ellis KANSAS

SEC. 23	TWP. 15	R. 18 W	✓
---------	---------	---------	---

WELL NO. # 1 Pfannensteil FARM

COMPANY Jones, Shelburne & Farmer


CONTRACTOR D & M Drlg.
Bielman Pool

_____ Ft. from N. Line

990 _____ Ft. from S. Line

330 _____ Ft. from E. Line

_____ Ft. from W. Line

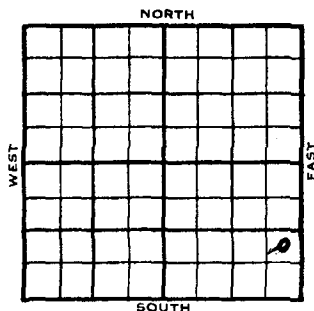

NE SE SE
Stanolind Farmout

(Information Brought Forward)

1953
12/2

CO to 3548' 1 1/4 boph 10 hrs., 300A
S/5 1/2 boph 6 hrs.
P/60 bfpd 65% wtr.
Comp. 22 bopd 80% wtr.

COMPLETED

	ELEVATION	REPORT
1953	1956'	
9/23	Spud 9-21-53	
9/30	8" @ 1000'	
	Anhy 1125'	
	Drlg 2982'	
10/7	Heeb 3206' Tor 3225' Lans 3243'	
	Arb. 3542'	
	DST 3542-48', 1 hr, 150' gas, 152' free	
	oil, 970# RTD 3548' 5" @ 3542'	
10/14	NR	
10/21	NR	
10/28	CO 3548' 1 1/4 BOPH 10 hrs., 300A	
	S/5 1/2 BOPH 6 hrs.	
11/4	NR	
11/11	P/60 bfpd 60% wtr.	
11/18	NR	
12/2	Spud 9-21-53	
	Oil Well	
	TD 3548'	
	8" @ 1000'	
	Anhy 1125', Heeb 3206', Tor 3225',	
	Lans 3243, Arb. 3542'	
	DST 3542-48', opn 1 hr., rec. 150'	
	gas, 152' free oil, 970#	
	TD 3548'	
DX-78	5" @ 3542'	

OVER

Ellis

FORM 51

KANSAS

Section 23 Township 15 Range 18W

Well No. #1 Pfannensteil

Company Jones, Shelburne & Farmer

