

Ellis

KANSAS ✓

Sec. 24 Twp. 15 R. 18W

Well No. #1 Witt Farm

Witt Bros. Company

Mast Drlg. Contractor
Wheatland Pool


Ft. from N. Line

330 Ft. from S. Line

Ft. from E. Line

330 Ft. from W. Line

SW SW NW

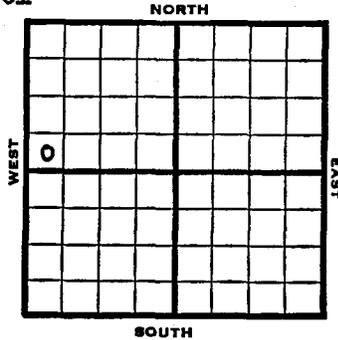


Ellis

KANSAS

Section 24 Township 15 Range 18W

Well No. #1 Witt

Company Witt Bros.

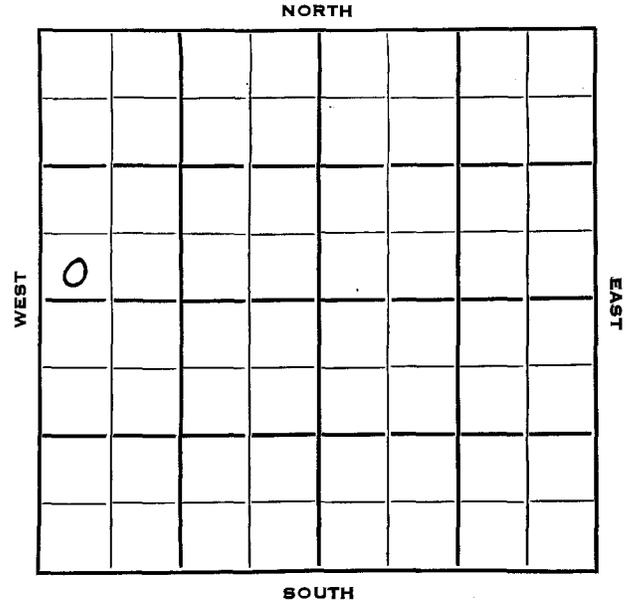

1953 Elev. 1966' REPORT

5/6 Spud 5-2-53
Anhy 1133'
8" @ 1143'
Drlg 1500'

5/20 Spud 5-2-53
D&A
TD 3581
Anhy 1133
8" @ 1143
Heeb 3218, ^T or 3235, KC 3265, Cong
3444, Arb. 3574
DST 3575-81, opn 1 hr., rec. 90'
sul wtr., 1030#
D&A

ABANDONED