

County Ellis Elev. 18W
Sec. 24 Twp. 15 Rge. 18W
Company Wilkinson Drlg.
Farm Name Kansas State College 1

TOPS	DEPTH	LOG	DATUM	Loc. in Sec.
Anh.				NE NE NW
Tr.				SE
H.				
Tr.				
Dg.				
Bl.				
L.				
K.C.				Geol.
B.M.C.				Contr.
Ce.				Co. tools
C.				
M.				Pool
K.				E. Leiker
Mz.				
Me.				
V.				
S.				
S.				
A.				
R.				
Pe.				
G.				

First Report
JUL 24 '57

Date Comm. RUR

14

CORRECTION

County Ellis Elev. 1991
Sec. 24 Twp. 15 Rge. 18W
Company Wilkinson Drlg.
Farm Name Kansas State College 1

TOPS	DEPTH	LOG	DATUM	Loc. in Sec.
Anh.	<u>1136</u>			NE NE NW
Tr.	<u>2922</u>			SE
H.	<u>3237</u>			
Tr.	<u>3240</u>			
Dg.				
Bl.				
L.	<u>3288</u>			
K.C.				Geol.
B.M.C.				Contr.
Ce.	<u>3466</u>			Co. tools
C.				
M.				Pool
K.				E. Leiker
Mz.				
Me.				
V.				
S.				
S.	<u>3216</u>			
A.				
R.				
Pe.				
G.				

ABANDONED
AUG 7 '57

Date Comm. RUR JUL 31 '57 7-22-57 878 1146
1550 DST 2288-3238 1hr run
245' MSW FP 22-150 BHP 1068
120" @ 3480 AUG 8 '57
D & R

Ellis

KANSAS


SECTION 24 TOWNSHIP 15S RANGE 18W

WELL NO. #1-Kansas State College

COMPANY Wilkinson Drlg.

SE
NE NE NW

NORTH

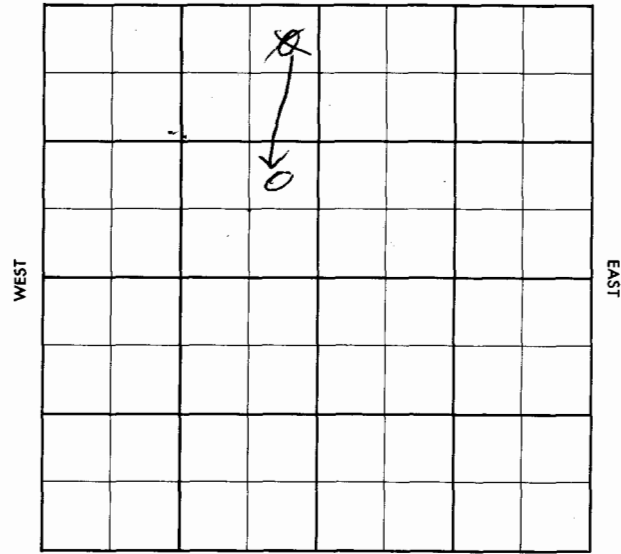

SOUTH