

County	Ellis	State	Kansas																																				
Sec.	24 (Bk. Twp.)	15 (Sur. Rge.)	18W Map No.																																				
Operator	Stanolind																																						
Well No.	3	Farm	C. Herl																																				
Elev.	Location NW SE NE																																						
<table border="1"> <tr> <td></td><td></td><td></td><td></td><td></td><td></td> </tr> <tr> <td></td><td></td><td></td><td></td><td></td><td></td> </tr> <tr> <td></td><td></td><td></td><td></td><td></td><td></td> </tr> <tr> <td></td><td></td><td></td><td></td><td></td><td></td> </tr> <tr> <td></td><td></td><td></td><td></td><td></td><td></td> </tr> <tr> <td></td><td></td><td></td><td></td><td></td><td></td> </tr> </table>																																							
990 Ft. From S Line NE																																							
990 Ft. From E Line Quarter																																							
1st. Report FEB 9 1955																																							
Completion																																							
Remarks																																							
Spudding Date																																							

Drlg. Data SW Wheatland Pool
Location

FABEN GILSTRAP

County	Ellis	State	Kansas																																				
Sec.	24 (Bk. Twp.)	15 (Sur. Rge.)	18W Map No.																																				
Operator	Stanolind																																						
Well No.	3	Farm	C. Herl																																				
Elev.	Location NW SE NE																																						
<table border="1"> <tr> <td></td><td></td><td></td><td></td><td></td><td></td> </tr> <tr> <td></td><td></td><td></td><td></td><td></td><td></td> </tr> <tr> <td></td><td></td><td></td><td></td><td></td><td></td> </tr> <tr> <td></td><td></td><td></td><td></td><td></td><td></td> </tr> <tr> <td></td><td></td><td></td><td></td><td></td><td></td> </tr> <tr> <td></td><td></td><td></td><td></td><td></td><td></td> </tr> </table>																																							
990 Ft. From S Line NE																																							
990 Ft. From E Line Quarter																																							
1st. Report																																							
Completion MAR 23 1955																																							
Remarks SW Wheatland Pool																																							
D & M Drlg. - Contr.																																							
Spudding Date 2-21-55																																							

Drlg. Data D & A TD 3674
8" @ 1159 Anhy 1153 Heeb. 3241
Lens. 3295 Arb. 3603 DST 3603-16
open 1½ hr. Rec. 125' msw 1075#
TD 3674 5" @ 3666 CO to 3624
20/ 3319-24 dry 1000 A CO to 3674
D & A

FABEN GILSTRAP

Ellis

KANSAS

SEC.	TWP.	R.
24	15	18W

WELL NO.

#3 C. Herl

FARM

COMPANY

Stanolind

CONTRACTOR

SW Wheatland Pool

NORTH

Ft. from N. Line


990

Ft. from S. Line

990

Ft. from E. Line

Ft. from W. Line

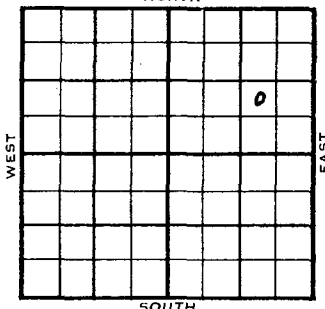

NW SE NE

1955

ELEVATION

1996'

REPORT

2/9
3/23

Location

Spud 2-21-55, D&A, TD 3674
 8" @ 1159, Anhy 1153, Heeb
 3241, Lans 3295, Arb 3603,
 DST 3603-16, open 1 1/2 hr, Rec
 125' MSW 1075#, TD 3674, 5" @
 3666 CO to 3624 20/3319-24,
 dry 1000 A CO to 3674,
 D&A

ABANDONED

DX-78

Ellis

KANSAS

DX 78-1

Section 24 Township 15 Range 18W

Well No. #3 C. Herl

Company Stanolind

NORTH

