

County Ellis State Kansas

Sec. 24 (Blk. Twp.) 15 (Sur. Rge.) 18W Map No.

Operator Jones, Shelburne & Farmer

Well No. 1 Farm Bielman

Elev. \_\_\_\_\_ Location SW SW SW


330 Ft. From S Line SW

330 Ft. From W Line Quarter

1st. Report JUL 16 1952

Completion \_\_\_\_\_

Remarks \_\_\_\_\_

Stanolind - JHM

Spudding Date \_\_\_\_\_

Drig. Data \_\_\_\_\_

Drig. 400

J. G. McGEHEE

County Ellis State Kansas

Sec. 24 (Blk. Twp.) 15 (Sur. Rge.) 18W Map No.

Operator Jones, Shelburne & Farmer

Well No. 1 Farm Bielman

Elev. 1924 Location SW SW SW


330 Ft. From S Line SW

330 Ft. From W Line Quarter

1st. Report \_\_\_\_\_

Completion OCT 15 1952

Remarks \_\_\_\_\_

Spudding Date 7-13-52

Drig. Data Oil well TD 3502

8" @ 790 Anhy 1077 Heeb. 3152

Dodge 3168 Lans. 3190 DST 3199-3267

open 1/2 hr. Rec. 30' mud B KC 3441

Cong. 3476 Arb. 3490 TD 3493

5" @ 3491 CO to 3493 DD 3496

S/ 2 goph 500 A DD 3502 S/ 1 boph

500 A S/ 3 boph 1000 A S/ 5 boph

Comp. 75 bopd 40% wtr.

J. G. McGEHEE

Ellis

KANSAS 18W ✓

Sec. 24 Twp. 15 R. 18W

Well No. #1 Bielman Farm

Jones, Shelburen & Farmer Company

Contractor


Ft. from N. Line

330' Ft. from S. Line

Ft. from E. Line

330' Ft. from W. Line

SW SW SW

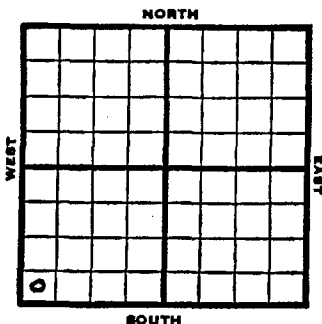

1952

10/15 5" @ 3491 CO to 3493 DD 3496  
S/ 2 goph 500 A DD 3502  
S/ 1 boph 500 A S/ 3 boph  
1000 A S/ 5 boph  
Comp. 75 bopd 40% wtr.

COMPLETED

1952	Elev. 1924'	REPORT
7/16	Drlg. 400'	
7/23	8" @ 790'	
	Anhy 1077	Heeb. 3152
	Dodge 3168	Lans. 3190
	DST 3199-3267, 1/4 hr. 30' m	
	Drlg. 3270'	
7/30	B KC 3441' Cong. 3476' Arb. 3490'	
	RTD 3493' 5" @ 3491'	
8/6	CO 3493' SO DD 3496 S/2 galoph	
	500 A no help.	
8/13	NR	
8/20	"	
8/27	"	
9/3	DP	
9/10	DD 3502' TD S/1 BOPH 500 A	
	S/3 BOPH 1000 A S/5 BOPH	
9/17	NR	
9/24	"	
10/1	NR	
10/15	Spud 7-13-52	
	Oil Well TD 3502' 8" @ 790	
	Anhy 1077	Heeb. 3152
	Dodge 3168	Lans. 3190
	DST 3199-3267 open 1/4 hr. rec. 30' mud	
	B KC 3441	Cong. 3476
	Arb. 3490	TD 3493

OVER

Ellis

KANSAS

Section 24 Township 15 Range 18W

Well No. #1 Bielman

Company Jones, Shelburne & Farmer

