


Ellis Kansas

County **Ellis** State **Kansas**
 Sec. **11** (Blk.) **15** (Sur.) **19W** Map No.
 Operator **Petroleum Inc.**
 Well No. **1** Farm **Wilson (B)**
 Elev. _____ Location **SE NE NE**

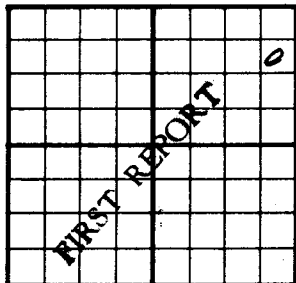

990 ft. From **N** Line **NE**
330 ft. From **E** Line Quarter
 1st. Report **AUG 6 1952**
 Completion _____
 Remarks _____
 Spudding Date _____

Drig. Data

Drig.


Map No. _____ Sec. **1** Twp. **15** R. **19W**
 Well No. **1** **Wilson (B)**

Petroleum Inc. Company

Contractor

SE NE NE

SECTION PLAT

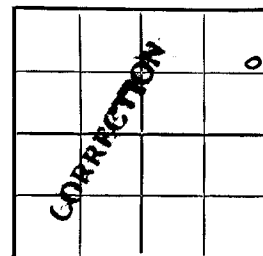

990 Ft. from N. Line
 _____ Ft. from S. Line
330 Ft. from E. Line
 _____ Ft. from W. Line

Location

Rig up

Drilling and Remarks:

Reported

Sec 11-15-19W

RECORD

Cased _____ in., _____ ft.

Sand _____

Gas _____

Oil _____

Total Depth _____

PRODUCTION

1st 24 hrs. Nat. _____

1st 24 hrs. after shot _____

Gas _____ Cu. Ft.

Dry Hole _____

Abandoned _____

Date

AUG 13 1952**J. G. McGEHEE**

Scout

J. G. McGEHEE

Ellis

KANSAS



1952


9/24

DST 3412-35 open 1 hr. rec. 135' wtr.
900# Cong. 3609 Arb. 3669
DST 3606-75 open 1 hr. rec. 590' wtr.
TD 3675' 5" @ 3450' 21/ 344-46
SSO&W 50/ 3344-46 200 A
S/ 9 boph P/ 96 bo 21 hr.
Comp. 83 boph

Sec. 11 Twp. E R. 19 W
Well No. # 1 Wilson (B) Farm
Petroleum Inc. Company
Contractor

990 Ft. from N. Line
Ft. from S. Line
330 Ft. from E. Line
Ft. from W. Line

SE NE NE

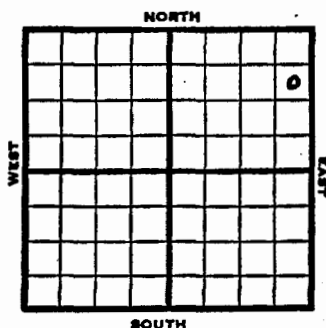

COMPLETED

1952	Elev. 2047' REPORT
8/6	Drilling
8/13	8" @ 191' Anhy 1240 Heeb. 3277 Tor. 3297 Lans. 3323 DST 3329-60, 1 hr. 3200' gas & 2060' gassy oil & 520' SW 1060# DST 3360-70, 3/4 hr. 10' m 870# DST 3380-3410, 1 hr. 720' SO&GCSW 780# Drlg. 3420'
8/20	DST 3412-35, 1 hr, 135' wtr. 900# Cong. 3609' Arb. 3669' DST 3606-75, 1 hr, 590' wtr. RTD 3675' 5" @ 3450 WOC
8/27	21/3344-46 SSO&W 50/3344-46 200 A S/9 BOPH 2700' off Btm
9/3	NR
9/10	P/96 BO 21 hrs.
9/17	NR
9/24	Spud 8-2-52 Oil Well TD 3675' 8" @ 191 Anhy 1240 Heeb. 3277 Tor. 3297 Lans. 3323 DST 3329-60 open 1 hr. rec. 3200' gas 2060' gassy oil 520' SW 1060# DST 3360-70 open 3/4 hr. rec. 10' mud 870# DST 3380-3410 open 1 hr. rec. 720' SO&GCSW 780#
	OVER

Section ~~24~~ 1 Township 15 Range 19W


Well No. #1 Wilson (B)

Company Petroleum Inc.

County Ellis State Kansas
 Sec. 1 (Blk. Twp.) 15 (Sur. Rge.) 19W Map No.
 Operator Petroleum Inc.

Well No. 1 Farm Wilson "B"

Elev. 2047 Location SE NE NE

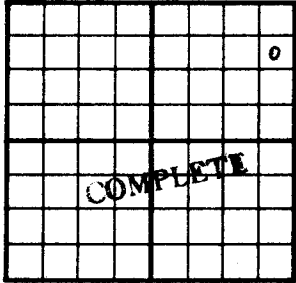

990 Ft. From N Line NE

330 Ft. From E Line Quarter

1st. Report

Completion SEP 24 1952

Remarks

Spudding Date 8-2-52

Drig. Data Oil well TD 3675

8" @ 191 Anhy 1240 Heeb. 3277

Tor. 3297 Lans. 3323 DST 3329-60

open 1 hr. Rec. 3200' gas 2060' gassy oil

520' sw 1060# DST 3360-70 open 3/4 hr.

Rec. 10' mud 870# DST 3380-3410

open 1 hr. Rec. 720' so & gcsw 780#

DST 3412-35 open 1 hr. Rec. 135' wtr.

900# Cong. 3609 Arb. 3669

DST 3606-75 open 1 hr. Rec. 590' wtr.

TD 3675 5" @ 3450 21/ 3344-46

SSO & W 50/ 3344-46 200 A S/ 9 boph

P/ 96 bo 21 hr. Comp. 83 bopd

J. G. McGEHEE

