

County	Ellis	State	Kansas
Sec.	1 (Blk. Twp.)	15 (Sur. Rge.)	19W Map No.
Operator	Petroleum Inc.		
Well No.	2 Farm Wilson "B"		
Elev.	Location NE SE NE		
	990 Ft. From	S Line	NE
	330 Ft. From	E Line	Quarter
	1st. Report MAY 27 1953		
	Completion		
	Remarks		
Petroleum Inc - Contr.			
Spudding Date 5-21-53			
Drig. Data	Antonino Pool		
drig. 2580			

J. G. McGEHEE

County	Ellis	State	Kansas
Sec.	1 (Blk. Twp.)	15 (Sur. Rge.)	19W Map No.
Operator	Petroleum Inc.		
Well No.	2 Farm Wilson "B"		
Elev.	Location NE SE NE		
	990 Ft. From	S Line	NE
	330 Ft. From	E Line	Quarter
	1st. Report		
	Completion JUN 24 1953		
	Remarks		
Antonino Pool			
Petroleum Inc. - Contr.			
Spudding Date 5-21-53			
Drig. Data	Oil well TD 3640		
8" @ 192 Heeb. 3281 Tor. 3300			
Lans. 3328 DST 3334-60 open 1 hr.			
Rec. 220' o & gcm 120' ocw 120' sw			
415# Cong. 3610 Arb. 3628 DST 3628-40			
open 1 hr. Rec. 155' oil 500#			
TD 3640 5" @ 3629 CO to 3638			
10/ 3634-37 250 A 8-1 3/4 bopd 8 hr.			
Comp. 25 bopd			

J. G. McGEHEE

Ellis

KANSAS

FORM 51

Ellis KANSAS

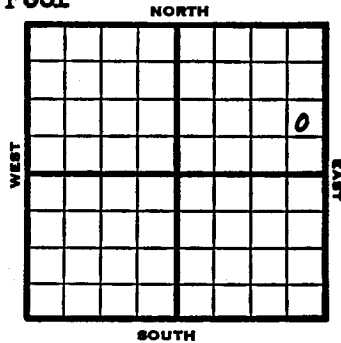
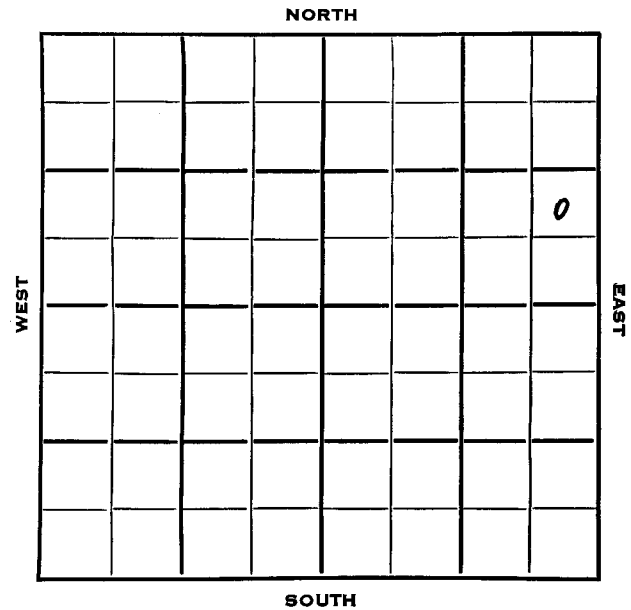
Sec. 1 Twp. 15 R. 19WWell No. #2 Wilson "B" FarmPetroleum Inc. CompanyPetroleum Inc. ContractorAntinino Pool

Ft. from N. Line

990 Ft. from S. Line330 Ft. from E. Line

Ft. from W. Line

NE SE NE

Section 1 Township 15 Range 19 WWell No. # 2 Wilson "B"Company Petroleum Inc.

1953 Elev. 2052' REPORT

5/27 Spud 5-21-53
Drilg 2580'

6/3 8" @ 192'
 Anhy, Heeb 3281, Tor 3300, Lans 3328,
 DST 3334-60 1 hr, 220' o & gcm, 120'
 ocw. 120' sw 415# Cong 3610, Arb
 3628
 DST 3628-40 1 hr, 155' oil, 500#
 RTD 3640'
 5" @ 3629'

6/10 CO 3638 10/ 3634-37 250 A S/ 1-3/4
 boph 8 hrs. POP

6/24 Spud 5-21-53 Oil well TD 3640
 8" @ 192 Heeb 3281 Tor. 3300
 Lans. 3328
 DST 3334-60 open 1 hr rec 220' O &
 GCM, 120' OCW, 120' SW 415#
 Cong. 3610 Arb. 3628
 DST 3628-40 open 1 hr rec 155' oil
 500# TD 3640 5" @ 3629 CO to
 3638' 10/3634-37 250 A S/1-3/4
 BOPH 8 hr.
 Comp. 25 BOPD

COMPLETED