

Sec. 2 Twp. 15 R. 19W

Well No. #1 Rack Farm

A.W.Ault Company

Wildcat Contractor


Ft. from N. Line

330' Ft. from S. Line

Ft. from E. Line

330' Ft. from W. Line

SW SW SW

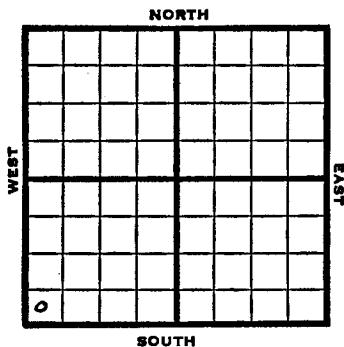


Section 2 Township 15 Range 19W

Well No. #1 Rack

Company A. W. Ault

NORTH

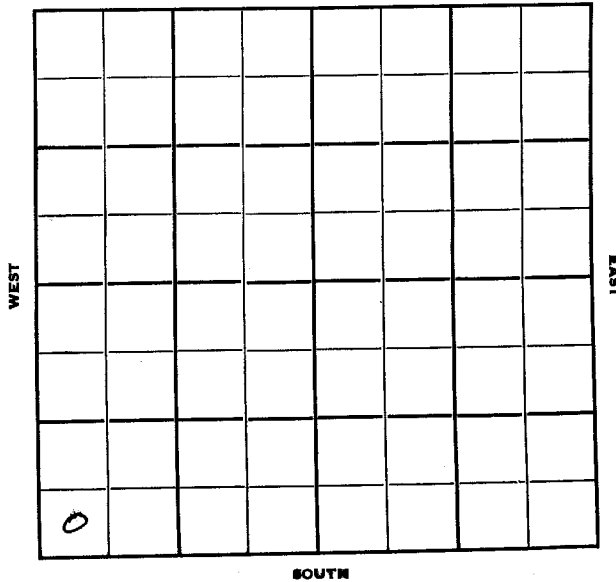

SOUTH

1950 Elev 2046 REPORT

8/30 Cellar & Pits

9/13 Spud 8-29-50

10" @ 170

Anhy 1264

Toronto 3308

B KC 3588

DST 3668-75

Arb 3691-3746 TD

TD 3746

D&A

Heeb 3291

Lans 3336

Cong 3668

ABANDONED