



Sec. 10 Twp. 15 R. 19 W

Well No. # 1 Gabel Farm

Bailey & Strain Drlg. Company


Contractor

330 Ft. from N. Line

Ft. from S. Line

330 Ft. from E. Line

Ft. from W. Line

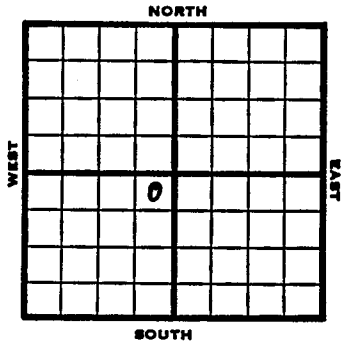

NE NE SW
Texas - DHM

1953 Elev. 2037' REPORT

8/26 Spud 8-22-53
8" @ 182 Anhy 1209'

Drlg. 1770'

9/2 Spud 8-22-53

D&A

TD 3730

8" @ 182

Anhy 1209, Heeb 3287, Tor 3305,

Lans 3331

DST 3354-3420, opn 1 hr., rec. 5'

oil, 235' sw, 1145#

Cong 3645, Arb. 3706

TD 3730

D&A


ABANDONED

Section 10 Township 15 Range 19 W

Well No. # 1 Gabel

Company Bailey & Strain Drlg.

NORTH

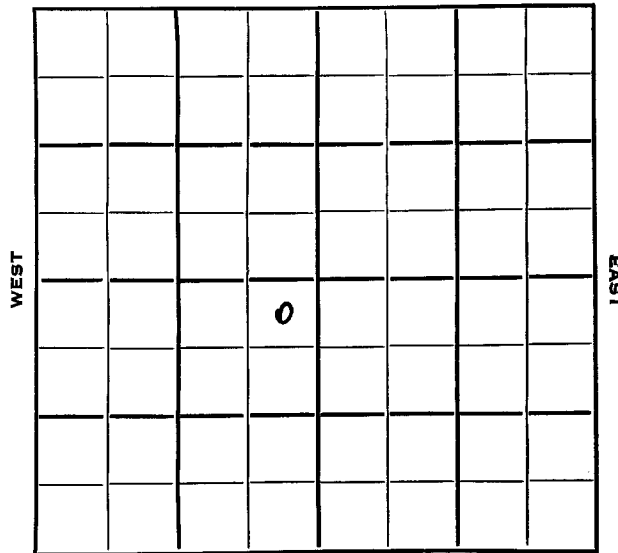

SOUTH