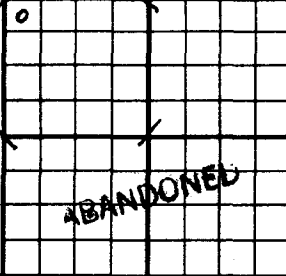


Ellis

KANSAS


Sec. 15 Twp. 15 R. 19W

|                                                                                  |                           |                |             |
|----------------------------------------------------------------------------------|---------------------------|----------------|-------------|
| County                                                                           | Ellis                     | State          | Kansas      |
| Sec.                                                                             | 15 (Blk. Twp.)            | 15 (Sur. Rge.) | 19W Map No. |
| Operator                                                                         | Jones, Shelborne & Farmer |                |             |
| Well No.                                                                         | 1                         | Farm           | Werth       |
| Elev.                                                                            | 2022                      | Location       | NW NW NW    |
|  |                           |                |             |
| 330 Ft. From N Line                                                              |                           | NW             |             |
| 330 Ft. From W Line                                                              |                           | Quarter        |             |
| 1st. Report                                                                      |                           |                |             |
| Completion JAN 3 1951                                                            |                           |                |             |
| Remarks Wildcat                                                                  |                           |                |             |
| Jones, Shelborne & Farmer                                                        |                           |                |             |
| Spudding Date 12-19-50                                                           |                           |                |             |

Drilg. Data D & A TD 3660  
 8 5/8" @ 162 Top. 3057 Heeb. 3277  
 Lans. 3324 Cong. 3613 Sd. Cong. 3639  
 Arb. 3649 DST 3649-55 open 1 hr.  
 Rec. 30' oil 60' water TD 3660  
 D & A

J. E. TYRA

|                           |                  |            |      |
|---------------------------|------------------|------------|------|
| Well No.                  | #1               | Werth      | Farm |
| Jones, Shelborne & Farmer |                  | Company    |      |
| Jones, Shelborne & Farmer |                  | Contractor |      |
| Wildcat                   |                  |            |      |
| 330'                      | Ft. from N. Line |            |      |
| Ft. from S. Line          |                  |            |      |
| Ft. from E. Line          |                  |            |      |
| 330'                      | Ft. from W. Line |            |      |
| NW NW NW                  |                  |            |      |

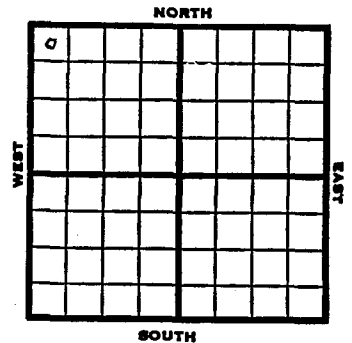

| 1950        | Elev. 2022' REPORT   |
|-------------|---|
| 12/20       | Spud 12-19-50   |
| 1951<br>1/3 | Spud 12-19-50<br>D&A TD 3660<br>8-5 8" @ 162' Top. 3057<br>Heeb. 3277' Lans. 3324 Cong. 3613<br>Sd. Cong. 3639 Arb. 3649<br>DST 3649-55 opn 1 hr<br>Rec. 30' oil 60' water TD 3660'<br>D&A<br><br>ABANDONED |

County Ellis State Kansas

Sec. 15 (Blk. Twp.) 15 (Sur. Rge.) 19W Map No.

Operator Jones, Shelborne & Farmer

Well No. I Farm Werth

Elev. \_\_\_\_\_ Location NW NW NW

330 Ft. From N Line NW

330 Ft. From W Line Quarter


1st. Report DEC 20 1950

Completion \_\_\_\_\_

Remarks Jones, Shelborne & Farmer

Spudding Date 12-19-50

Drlg. Data Wildcat

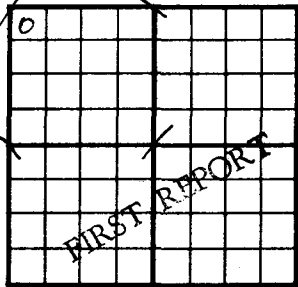

J. E. TYRA

Ellis **KANSAS**

Section 15 Township 15 Range 19W

Well No. #1 Werth

Company Jones, Shelborne & Farmer

